

**SURVEY & REMONUMENTATION**

APR 27 1995

1994 REMONUMENTATION PROGRAM

DEED LIBER 2565 PAGE 878

**COMMISSION**

**LAND CORNER RECORDATION CERTIFICATE**  
Filing Requirement of Act 74, Mich. P.A. 1970

For corners in

<u>GENESEE</u> (County)	Located in: MUNDY	Corner Code: #1
1. Public Land Survey	T <u>6N</u> R <u>6E</u>	A-3
	T _____ R _____	_____
	T _____ R _____	_____
	T _____ R _____	_____
2. Property Controlling In Section	S _____ T _____ R _____	_____
	S _____ T _____ R _____	_____
3. Miscellaneous Property in Sec.	S _____ T _____ R _____	_____
	S _____ T _____ R _____	_____

RECORDED  
FEB 16 7 37 AM '95  
7788  
Register of Deeds Stamp & File Number

4. Lot No. \_\_\_\_\_, Recorded Plat \_\_\_\_\_  
5. Private Claims \_\_\_\_\_

	A	B	C	D	E	F	G	H	I	J	K	L
2	6	5	4	3	2							
3												
4	7	8	9	10	11	12						
5												
6	18	17	16	15	14	13						
7												
8	19	20	21	22	23	24						
9												
10	30	29	28	27	26	25						
11												
12	31	32	33	34	35	36						
13												

I, RICHARD H. KRAFT, P.S. in a field survey on OCTOBER 24, 19 94  
do hereby certify that under requirements of P.A. 74, Michigan P.A. of 1970, the corner points mentioned in lines 1 and 2 above were in conformance with regulations and rules therefore as required in the current manual of survey instructions of the United States Department of the Interior, Bureau of Land Management or by a decree of a Court of Law and/or that the corner points mentioned in lines 3, 4 and 5 above were in conformance with the rules of the Michigan Board of Land Surveyors or by a Decree of a Court of Law; established, re-established, monumented, re-monumented, recovered, found as expressed below:

NOTE: Not more than 4 corners, all in the same town and range, may be recorded on this certificate.

A. Description of original monument and accessories and/or subsequent restoration:  
1823 GLO; HARVEY PURKE, D.S.; SET POST, NO ACCESSORIES  
1926 GCRC; FOUND STONE, 6 ACCESSORIES  
1965 GCRC; FOUND STONE, 5 ACCESSORIES  
1973 K.PIOTROWSKI, R.L.S. LCRC, FOUND RAILROAD SPIKE, 3 ACCESSORIES

B. Description of corner evidence found and/or method applied in restoring or reestablishing corner:

1994 GENESEE COUNTY REMONUMENTATION PROGRAM

FOUND 1/2" ROD  
1 ACCESSORY, 1926  
2 ACCESSORIES, 1973


Ratified by Peer Group in accordance with P.A. 345, 1990  
Co. Richard H. Kraft  
Date 12-21-94

RATIFIED BY GENESEE COUNTY PEER GROUP DECEMBER 21, 1994

C. Description of monument for corner and accessories established to perpetuate locating the position of the corner:

SET STANDARD GENESEE COUNTY MONUMENT

NORTH, 66.25' FOUND P.K. IN BIT., NE CORNER, SECTION 12, T6N-R5E  
S25°E, 79.26' SET NAIL&GC TAG IN 6" MAPLE  
S35°W, 47.0' FOUND NAIL & CAP (CHMP) IN POWER POLE  
S45°W, 90.31' CENTER OF ROAD SIGN  
S85°W, 45.88' SW CORNER "B" COVER/BACK OF CURB  
S80°E, 46.30' SE CORNER "B" COVER/BACK OF CURB

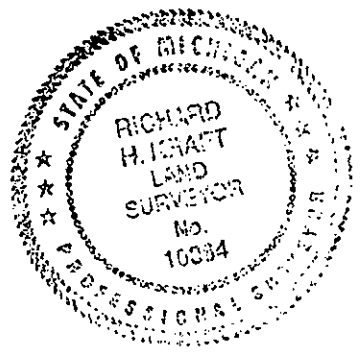

Signed by Richard H. Kraft Date DECEMBER 31, 1994  
Surveyor's Michigan License No. 10064