

SURVEY & REMONUMENTATION

DEED LIBER 2565 PAGE 879

APR 27 1995

1994 REMONUMENTATION PROGRAM

LAND CORNER RECORDATION CERTIFICATE
Filing Requirement of Act 74, Mich. P.A. 1970


COMMISSION

For corners in

<u>GENESEE</u> (County)	Located in:	Corner Code #/1
	<u>MUNDY</u>	
1. Public Land Survey	T <u>6N</u> R <u>6E</u>	<u>B-3</u>
	T _____ R _____	_____
	T _____ R _____	_____
	T _____ R _____	_____
2. Property Controlling In Section	S _____ T _____ R _____	_____
	S _____ T _____ R _____	_____
3. Miscellaneous Property In Sec.	S _____ T _____ R _____	_____
	S _____ T _____ R _____	_____

RECORDED
FEB 16 7 37 AM '95
7789
Register of Deeds Stamp & File Number

4. Lot No. _____, Recorded Plat _____
5. Private Claims _____

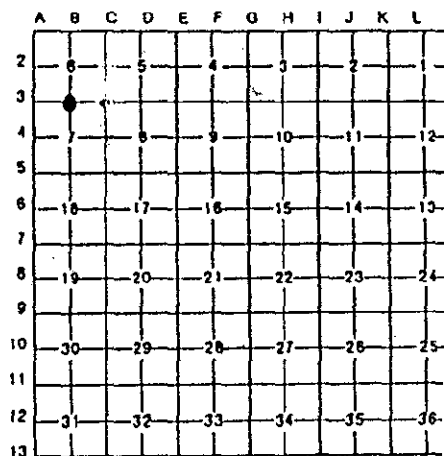

I, DAVID J. KENNEY, P.S. in a field survey on OCTOBER 24, 19 94, do hereby certify that under requirements of P.A. 74, Michigan P.A. of 1970, the corner points mentioned in lines 1 and 2 above were in conformance with regulations and rules therefore as required in the current manual of survey instructions of the United States Department of the Interior, Bureau of Land Management or by a decree of a Court of Law and/or that the corner points mentioned in lines 3, 4 and 5 above were in conformance with the rules of the Michigan Board of Land Surveyors or by a Decree of a Court of Law; established, re-established, monumented, re-monumented, recovered, found as expressed below:

NOTE: Not more than 4 corners, all in the same town and range, may be recorded on this certificate.

- A. Description of original monument and accessories and/or subsequent restoration:
- 1823 GLO; HARVEY PARKE, D.S. - SET POST, NO ACCESS
 - 1926 GCRC; FOUND PLOW POINT, SET 6 ACCESSORIES
 - 1965 GCRC; FOUND IRON PIPE - SET MONUMENT BOX, SET 4 ACCESSORIES
 - 1973 KAROL PIOTROWSKI, R.L.S. - FOUND 3/4" IRON IN MONUMENT BOX, RECORDED 4 ACCESSORIES L. 1863, PAGE 106
 - 1975 RICHARD FRANK, R.L.S. - FOUND MONUMENT BOX, SET 4 ACCESSORIES

B. Description of corner evidence found and/or method applied in restoring or reestablishing corner:

1994	DAVID KENNEY - FOUND 1/2" ROD IN MONUMENT BOX
1973	KAROL PIOTROWSKI
	SOUTH - CENTERLINE OF PAVEMENT
	NORTH - RR SPIKE IN 30' HICKORY
	S15°E - GUY POLE
	SOUTH - N. FACE OF R/W MARKER

RECORDED	MEASURED
0.5'	0.5'
51.35'	52.57'
59.90'	60.15'
59.57'	59.67'


RATIFIED BY GENESEE COUNTY PEER GROUP DECEMBER 21, 1994.

Ratified by Peer Group in accordance with P.A. 345, 1990
Co. Barold D. Carlson
Date 12-21-94

C. Description of monument for corner and accessories established to perpetuate locating the position of the corner:

B-3 SET STANDARD GENESEE COUNTY MONUMENT IN MONUMENT BOX

NORTH	FOUND P.K. -W- FACE OF 18" HICKORY	52.57'
S25°E	FOUND NAIL AND TAG IN POWER	60.15'
SOUTH	FACE R/W MARKER	59.67'
S60°W	FOUND NAIL AND TAG IN POWER POLE	80.12'

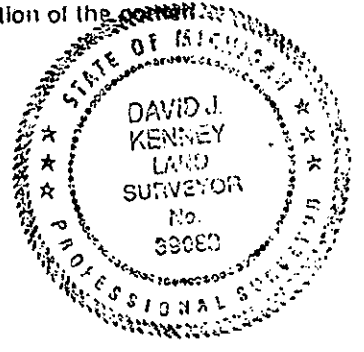

Signed by David J. Kenney Date DECEMBER 31, 1994
Surveyor's Michigan License No. 39083