

**SURVEY & REMONUMENTATION**

APR 27 1995

**COMMISSION**

1994 REMONUMENTATION PROGRAM

**LAND CORNER RECORDATION CERTIFICATE**  
Filing Requirement of Act 74, Mich. P.A. 1970

DEED LIBER 2565 PAGE 880

For corners in

GENESEE (County)	Located In:	Corner Code =#
	MUNDY	
1. Public Land Survey	T <u>6N</u> R <u>6E</u>	<u>C-3</u>
	T _____ R _____	_____
	T _____ R _____	_____
	T _____ R _____	_____
2. Property Controlling In Section	S _____ T _____ R _____	_____
	S _____ T _____ R _____	_____
3. Miscellaneous Property In Sec.	S _____ T _____ R _____	_____
	S _____ T _____ R _____	_____

RECORDED  
REGISTERED  
FEB 16 7 37 AM '95  
7790  
FILED

Register of Deeds Stamp & File Number

4. Lot No. \_\_\_\_\_, Recorded Plat \_\_\_\_\_  
5. Private Claims \_\_\_\_\_

	A	B	C	D	E	F	G	H	I	J	K	L
2	6	5	4	3	2	1						
3	7	8	9	10	11	12						
4												
5												
6	18	17	16	15	14	13						
7												
8	19	20	21	22	23	24						
9												
10	30	29	28	27	26	25						
11												
12	31	32	33	34	35	36						

DAVID J. KENNEY, P.S. In a field survey on, OCTOBER 25, 19 94, do hereby certify that under requirements of P.A. 74, Michigan P.A. of 1970, the corner points mentioned in lines 1 and 2 above were in conformance with regulations and rules therefore as required in the current manual of survey instructions of the United States Department of the Interior, Bureau of Land Management or by a decree of a Court of Law and/or that the corner points mentioned in lines 3, 4 and 5 above were in conformance with the rules of the Michigan Board of Land Surveyors or by a Decree of a Court of Law; established, re-established, monumented, re-monumented, recovered, found as expressed below:

NOTE: Not more than 4 corners, all in the same town and range, may be recorded on this certificate.

A. Description of original monument and accessories and/or subsequent restoration:

- 1823 GLO; HARVEY PARKE, D.S. - SET POST - NO ACCESSORIES
- 1926 GCRC; FOUND STONE - TILE - BRICK - SET 5 ACCESSORIES
- 1965 GCRC; SET IRON IN MONUMENT BOX - SET 4 ACCESSORIES
- 1973 KAROL PIOTROWSKI, R.L.S., FOUND 3/4" IRON ROD IN MONUMENT BOX, RECORDED 3 ACCESSORIES L 1863, PAGE 106

B. Description of corner evidence found and/or method applied in restoring or reestablishing corner:


- 1994 RICHARD H. KRAFT - FOUND RAILROAD SPIKE IN MONUMENT BOX
- 1973 K. PIOTROWSKI - FOUND 3/4" ROD IN MONUMENT BOX  
N30°E, TELEPHONE POLE, 63.53' (MEASURED 63.53')  
S45°W, POWER POLE 78.25' (MEASURED 78.28')

RATIFIED BY GENESEE COUNTY PEER GROUP DECEMBER 21, 1994.

Ratified by Peer Group in accordance with P.A. 345, 1990  
Co. Paul D. Carlson  
Date 12-21-94

C. Description of monument for corner and accessories established to perpetuate locating the position of the corner:

- C-3 SET GENESEE COUNTY STANDARD MONUMENT IN MONUMENT BOX
- NORTH - FOUND P.K. AND TAG IN LIGHT POLE 26.91'
- S30°E - FACE OF FENCE POST 55.63'
- S20°W - FOUND P.K. AND TAG IN POWER POLE 78.28'
- S25°E - TOP CORNER R/W MARKER 68.53'
- N30°E - FOUND P.K. AND TAG IN TELEPHONE POLE 63.53'

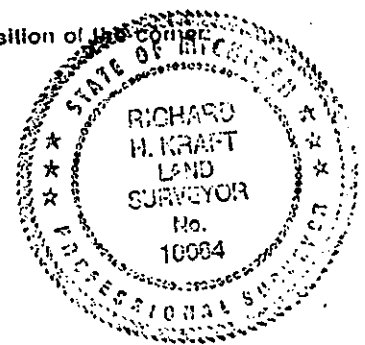

Signed by Richard H. Kraft Date DECEMBER 31, 1994