

SURVEY & REMONUMENTATION

1994 REMONUMENTATION PROGRAM

DEED LIBER 2565 PAGE 888

APR 27 1995

LAND CORNER RECORDATION CERTIFICATE
Filling Requirement of Act 74, Mich. P.A. 1970

For corners in
GENESEE COMMISSION
(County)

Located In: MUNDY Corner Code J-3

1. Public Land Survey	T <u>6N</u> R <u>6E</u>	_____
	T _____ R _____	_____
	T _____ R _____	_____
	T _____ R _____	_____
2. Property Controlling In Section	S _____ T _____ R _____	_____
	S _____ T _____ R _____	_____
3. Miscellaneous Property in Sec.	S _____ T _____ R _____	_____

RECORDED
REGISTERED
FEB 16 7 30 AM '95
7798
Register of Deeds Stamp & File Number

4. Lot No. _____, Recorded Plat _____
5. Private Claims _____

A	B	C	D	E	F	G	H	I	J	K	L	I
2	6	5	4	3	2	1						
3												
4	7	8	9	10	11	12						
5												
6	13	17	18	15	14	13						
7												
8	19	20	21	22	23	24						
9												
10	30	29	28	27	26	25						
11												
12	31	32	33	34	35	36						
13												

I, DAVID J. KENNEY, P.S. in a field survey on NOVEMBER 14, 19 94, do hereby certify that under requirements of P.A. 74, Michigan P.A. of 1970, the corner points mentioned in lines 1 and 2 above were in conformance with regulations and rules therefore as required in the current manual of survey instructions of the United States Department of the Interior, Bureau of Land Management or by a decree of a Court of Law and/or that the corner points mentioned in lines 3, 4 and 5 above were in conformance with the rules of the Michigan Board of Land Surveyors or by a Decree of a Court of Law; established, re-established, monumented, re-monumented, recovered, found as expressed below:

NOTE: Not more than 4 corners, all in the same town and range, may be recorded on this certificate.

A. Description of original monument and accessories and/or subsequent restoration:

- 1823 GLO; HARVEY PARKE, D.S. - SET POST - NO ACCESSORIES
- GCRC - FOUND IRON PIN - 4 ACCESSORIES
- 1935 GCRC (MDOT) - FOUND 1/2" RE-BAR - 3 ACCESSORIES
- 1973 KAROL PIOTROWSKI, LCRC - SET P.K. NAIL - 3 ACCESSORIES
- 1981 ELBEX HARRIS, LCRC - FOUND SPIKE - 5 ACCESSORIES
- 1991 GIL BONNO, LCRC - FOUND NAIL - 4 ACCESSORIES
- 1992 RICHARD KRAFT, R.L.S. - FOUND NAIL - 4 ACCESSORIES

B. Description of corner evidence found and/or method applied in restoring or reestablishing corner:

1994 GENESEE COUNTY REMONUMENTATION PROGRAM

- 2 ACCESSORIES, 1935
- 1 ACCESSORY, 1981
- 1 ACCESSORY, 1991

Ratified by Peer Group in accordance with P.A. 345, 1990


Co. Rep. Carl D. Carlson
Date 12-21-94

RATIFIED BY GENESEE COUNTY PEER GROUP DECEMBER 21, 1994.

C. Description of monument for corner and accessories established to perpetuate locating the position of the corner:

SET STANDARD GENESEE COUNTY MONUMENT IN MONUMENT BOX

- | | | |
|-------|----------|--|
| N20°E | 45.70' | SET P.K. & G.C. TAG IN W. FACE OF E'LY GUARD RAIL POST |
| NORTH | 56.81' | FOUND NAIL & TAG IN E. FACE POWER POLE |
| SOUTH | 39.45' | SET P.K. & G.C. TAG IN W. FACE POWER POLE |
| S25°W | 51.00' | CHISELED "X" IN N. EDGE MANHOLE |
| | 2636.26' | S 1/4 CORNER TO SW CORNER |

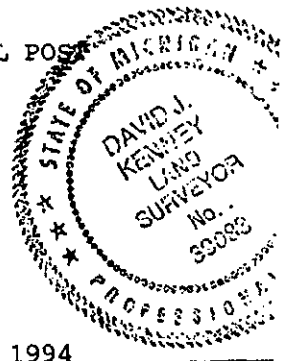

Signed by David J. Kenney Date DECEMBER 31, 1994
Surveyor's Michigan License No. 39083