

**SURVEY &  
REMONUMENTATION**

1994 REMONUMENTATION PROGRAM

APR 27 1995

**LAND CORNER RECORDATION CERTIFICATE**  
Filing Requirement of Act 74, Mich. P.A. 1970

For corners in **COMMISSION**

<u>GENESEE</u> (County)	Located In: <b>MUNDY</b>	Corner Code: <u>11</u>
1. Public Land Survey	T <u>6N</u> R <u>6E</u>	<u>K-3</u>
	T _____ R _____	_____
	T _____ R _____	_____
	T _____ R _____	_____
2. Property Controlling In Section	S _____ T _____ R _____	_____
	S _____ T _____ R _____	_____
3. Miscellaneous Property in Sec.	S _____ T _____ R _____	_____
	S _____ T _____ R _____	_____

RECORDED  
REGISTERED  
FEB 16 7 30 AM '95  
779  
Register of Deeds Stamp & File Number

4. Lot No. \_\_\_\_\_, Recorded Plat \_\_\_\_\_  
5. Private Claims \_\_\_\_\_

A	B	C	D	E	F	G	H	I	J	K	L
2	6	5	4	3	2						
3											
4	7	8	9	10	11						
5											
6	16	17	18	19	20	21	22	23	24	25	26
7											
8	19	20	21	22	23	24	25	26	27	28	29
9											
10	30	29	28	27	26	25	24	23	22	21	20
11											
12	31	32	33	34	35	36	37	38	39	40	41
13											

I, RICHARD H. KRAFT, P.S. in a field survey on DECEMBER 1, 19 94, do hereby certify that under requirements of P.A. 74, Michigan P.A. of 1970, the corner points mentioned in lines 1 and 2 above were in conformance with regulations and rules (hereafter as required in the current manual of survey instructions of the United States Department of the Interior, Bureau of Land Management or by a decree of a Court of Law and/or that the corner points mentioned in lines 3, 4 and 5 above were in conformance with the rules of the Michigan Board of Land Surveyors or by a Decree of a Court of Law; established, re-established, monumented, re-monumented, recovered, found as expressed below:

NOTE: Not more than 4 corners, all in the same town and range, may be recorded on this certificate.

A. Description of original monument and accessories and/or subsequent restoration:

- 1823 GLO; HARVEY PARKE, D.S. - SET POST - NO ACCESSORIES  
GCRC - FOUND PIPE - 4 ACCESSORIES
- 1965 GCRC - FOUND PIPE - SET MONUMENT BOX - 5 ACCESSORIES
- 1973 KAROL PIOTROWSKI, LCRC - FOUND 1/2" BOLT IN MONUMENT BOX - 2 ACCESSORIES
- 1977 EDWARD ANDERSON LCRC - FOUND MONUMENT BOX - 3 ACCESSORIES
- 1979 JAN FOLKENS, LCRC - FOUND 1/2" IRON IN MONUMENT BOX - 3 ACCESSORIES
- 1992 RICHARD H. KRAFT, R.L.S. - FOUND MONUMENT BOX - 4 ACCESSORIES

B. Description of corner evidence found and/or method applied in restoring or reestablishing corner:

1994 GENESEE COUNTY REMONUMENTATION PROGRAM

2 ACCESSORIES GCRC, NO DATE  
4 ACCESSORIES 1992


Ratified by Peer Group in accordance with P.A. 345, 1990  
Co. Rep. Carl D. Carlson  
Date 12-21-94

RATIFIED BY GENESEE COUNTY PEER GROUP DECEMBER 21, 1994.

C. Description of monument for corner and accessories established to perpetuate locating the position of the corner:

SET STANDARD GENESEE COUNTY MONUMENT IN MONUMENT BOX

N30°E 36.3' SET P.K. & G.C. TAG IN TOP WOOD GUARD RAIL POST  
N5 °W 30.3' FOUND NAIL & TAG IN TOP WOOD GUARD RAIL POST  
N50°W 29.5' FOUND NAIL & TAL IN TOP WOOD GUARD RAIL POST  
SOUTH 30.3' FOUND NAIL & TAG IN TOP WOOD GUARD RAIL POST

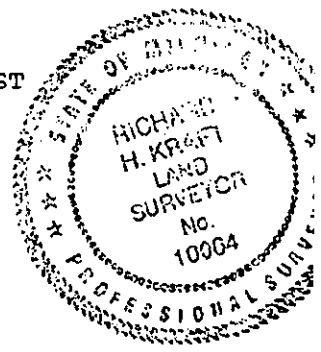

Signed by Richard H. Kraft Date DECEMBER 31, 1994  
Surveyor's Michigan License No. 10064