

**SURVEY &
REMONUMENTATION**

DEED LIBER 2565 PAGE 889

APR 27 1995

1994 REMONUMENTATION PROGRAM

LAND CORNER RECORDATION CERTIFICATE
Filing Requirement of Act 74, Mich. P.A. 1970

COMMISSION

For corners in

<u>GENESEE</u> (County)	Located in:	Corner Code #11
	<u>MUNDY</u>	
1. Public Land Survey	T <u>6N</u> R <u>6E</u>	<u>L-3</u>
	T _____ R _____	_____
	T _____ R _____	_____
	T _____ R _____	_____
2. Property Controlling in Section	S _____ T _____ R _____	_____
	S _____ T _____ R _____	_____
3. Miscellaneous Property in Sec.	S _____ T _____ R _____	_____
	S _____ T _____ R _____	_____
4. Lot No. _____, Recorded Plat _____		
5. Private Claims _____		

RECORDED
FEB 16 7 30 AM '95
REGISTERED
7799
Register of Deeds Stamp & File Number

	A	B	C	D	E	F	G	H	I	J	K	L
2	6	5	4	3	2							
3												
4	7	8	9	10	11							
5												
6	18	17	16	15	14							
7												
8	19	20	21	22	23							
9												
10	30	29	28	27	26							
11												
12	31	32	33	34	35							
13												

I, RICHARD H. KRAFT, PS in a field survey on, DECEMBER 1, 19 94, do hereby certify that under requirements of P.A. 74, Michigan P.A. of 1970, the corner points mentioned in lines 1 and 2 above were in conformance with regulations and rules therefore as required in the current manual of survey instructions of the United States Department of the Interior, Bureau of Land Management or by a decree of a Court of Law and/or that the corner points mentioned in lines 3, 4 and 5 above were in conformance with the rules of the Michigan Board of Land Surveyors or by a Decree of a Court of Law; established, re-established, monumented, re-monumented, recovered, found as expressed below:

NOTE: Not more than 4 corners, all in the same town and range, may be recorded on this certificate.

A. Description of original monument and accessories and/or subsequent restoration:

- 1823 GLO; HARVEY PARKE, D.S. - SET POST - NO ACCESSORIES
- 1895 GEORGE DOANE - SET LARGE STONE - 2 ACCESSORIES
- GCRC - CORNER NOT DESCRIBED, MEASURED S 1/4 TO SE & S 1/4 TO SW, 5 ACCESSORIES
- 1962 GCRC - MONUMENT BOX - 5 ACCESSORIES
- 1979 JAN FOLKENS, LCRC - FOUND 1/2" RE-ROD IN MONUMENT BOX - 3 ACCESSORIES

B. Description of corner evidence found and/or method applied in restoring or reestablishing corner:

1994 GENESEE COUNTY REMONUMENTATION PROGRAM

- 3 ACCESSORIES 1962
- 1 ACCESSORY 1979

Ratified by Peer Group in accordance with P.A. 345, 1990


Co. Richard H. Kraft
Date 12-21-94

RATIFIED BY GENESEE COUNTY PEER GROUP DECEMBER 21, 1994.

C. Description of monument for corner and accessories established to perpetuate localing the position of the corner:

SET STANDARD GENESEE COUNTY MONUMENT IN MONUMENT BOX

- N5 °W 50.36' FOUND NAIL & TAG IN POWER POLE
- N75°E 77.28' CHISELED "X" IN NE CORNER OF CATCH BASIN
- S5 °W 34.56' CHISELED "X" IN N. RIM MANHOLE
- S20°W 79.56' FOUND NAIL & TAG (#20709) IN POWER POLE

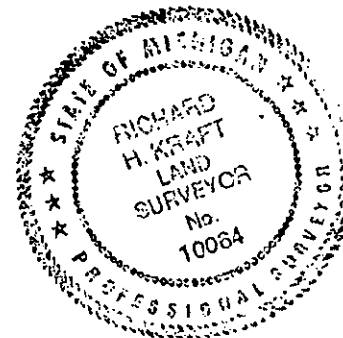

Signed by Richard H. Kraft Date DECEMBER 31, 1994
Surveyor's Michigan License No. 10064