

RECORDED
 REGISTERED
 Dec 29 11 33 AM '97

SECTION 1997 REMONUMENTATION PROGRAM
LAND CORNER RECORDATION CERTIFICATE
 Filing Requirement of Act 74, Mich. P.A. 1970

For corners in

<u>Genesee</u> (County)	Located In:	Corner Code #
1. Public Land Survey	T <u>6N</u> R <u>7E</u>	<u>C-4</u>
	T ___ R ___	_____
	T ___ R ___	_____
2. Property Controlling in Section	S ___ T ___ R ___	_____
	S ___ T ___ R ___	_____
3. Miscellaneous Property in Sec.	S ___ T ___ R ___	_____

GENESEE COUNTY
 Register of Deeds Stamp & File Number
900 [Signature]

4. Lot No. _____, Recorded Plat _____
 5. Private Claims _____

	A	B	C	D	E	F	G	H	I	J	K	L	M
1													
2	6			5		4		3		2		1	
3													
4	7		8		9		10		11		12		
5													
6	18		17		16		15		14		13		
7													
8	19		20		21		22		23		24		
9													
10	30		29		28		27		26		25		
11													
12	31		32		33		34		35		36		
13													

I, Kevin B. Cleaver, in a field survey on December 15, 19 97 do hereby state that under requirements of P.A. 74, Michigan P.A. of 1970, the corner points mentioned in lines 1 and 2 above were in conformance with regulations and rules therefore as required in the current manual of survey instructions of the United States Department of the Interior, Bureau of Land Management or by a decree of a Court of Law and for that the corner points mentioned in lines 3, 4 and 5 above were in conformance with rules of the Michigan Board of Land Surveyors or by a Decree of a Court of Law; established, re-established, monumented, recovered, found as expressed below:

NOTE: Not more than 2 corners, all in the same town and range, may be recorded on this certificate.

A. Description of original monument and accessories and/or subsequent restoration:

- 1823 GLO Set post and two (2) accessories
- 1957 GEI Survey for Crestwood Memorial Gardens
- Nov. 10, 1964 GEI Survey for Gerity Broadcasting, Co.,
- Date ? GEI No corner was found, set 1" x 30" Pipe Iron
- May 17, 1966 GEI Survey for Grant Auker
- Dec. 16, 1992 GEI Boundary Survey for Crestwood Memorial Cemetery,

B. Description of corner evidence found and/or method applied in restoring or reestablishing corner:

Found Pinch Pipe
 Found Distance C-4 to SW Corner of survey from November 10, 1964
 GEI Records; Found distance C-4 to C-4 from May 17, 1966
 GEI Records; Found distances C-3 to C-4 and C-4 to D-4 and Angle D-3, C-3, C-4 from December 16, 1992

The monument found was ratified by the Genesee County Peer Review Committee on December 18, 1997, as the accepted corner.


C. Description of monument for corner and accessories established to perpetuate locating the position of the corner:

Set the standard Bernsten monument SS-A-5-BR-30 with 3 1/4" brass cap stamped Genesee County Re-monumentation Corner 1997, #29242 over a pinch pipe.

- West, 2.51' - Found Nail and Tag #9431 in the East face of an anchor post
- East, 7.89 - Found Consumers Power Company 'T' iron
- S 10° W, 17.38' - Set re-mon. nail and tag in the East face of a 12" birch
- N 10° W, 17.44 - Found nail and tag in the East face of a 12" birch

Ratified by Peer Group in accordance with P.A. 345, 1990
 Co. Rep. Carl Carlson
 Date 12-18-97

Signed by Kevin Banfield Cleaver
 Kevin Banfield Cleaver, P.S.,
 Field Manager

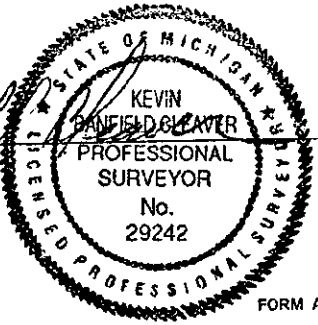

Date 12/24/97

Surveyor's Michigan License No. 29242

FORM APPROVED BY MICHIGAN STATE BOARD OF PROFESSIONAL SURVEYORS, JAN. 28, 1971

REVISED MAY 14, 1975

REVISED JAN., 1993 REVISED OCT., 1995