

SURVEY & REMONUMENTATION

MAR 05 1998

MASTER LIBER 3685 PAGE 942

RECORDED
REGISTERED
Dec 29 11 33 AM '97

SECTION

**1997 REMONUMENTATION PROGRAM
LAND CORNER RECORDATION CERTIFICATE
Filing Requirement of Act 74, Mich. P.A. 1970**

For corners in

| | | |
|---------------------------------------|-------------------------|---------------|
| <u>Genesee</u> (County) | Located In: | Corner Code # |
| 1. Public Land Survey | T <u>6N</u> R <u>7E</u> | <u>F-5</u> |
| | T _____ R _____ | _____ |
| | T _____ R _____ | _____ |
| 2. Property Controlling in Section | S _____ T _____ R _____ | _____ |
| | S _____ T _____ R _____ | _____ |
| 3. Miscellaneous Property in Sec. | S _____ T _____ R _____ | _____ |
| | S _____ T _____ R _____ | _____ |
| 4. Lot No. _____, Recorded Plat _____ | | |
| 5. Private Claims _____ | | |

GENESEE COUNTY REGISTER OF DEEDS

Gas filed me
Register of Deeds Stamp & File Number

| | | | | | | | | | | | | | |
|----|----|---|---|----|---|----|---|----|---|----|---|----|---|
| | A | B | C | D | E | F | G | H | I | J | K | L | M |
| 1 | | | | | | | | | | | | | |
| 2 | 6 | | | 5 | | 4 | | 3 | | 2 | | 1 | |
| 3 | | | | | | | | | | | | | |
| 4 | 7 | | | 8 | | 9 | | 10 | | 11 | | 12 | |
| 5 | | | | | | | | | | | | | |
| 6 | 18 | | | 17 | | 16 | | 15 | | 14 | | 12 | |
| 7 | | | | | | | | | | | | | |
| 8 | 19 | | | 20 | | 21 | | 22 | | 23 | | 24 | |
| 9 | | | | | | | | | | | | | |
| 10 | 30 | | | 29 | | 28 | | 27 | | 26 | | 25 | |
| 11 | | | | | | | | | | | | | |
| 12 | 31 | | | 32 | | 33 | | 34 | | 35 | | 36 | |
| 13 | | | | | | | | | | | | | |

I, Kevin B. Cleaver, in a field survey on December 15, 1997 do hereby state that under requirements of P.A. 74, Michigan P.A. of 1970, the corner points mentioned in lines 1 and 2 above were in conformance with regulations and rules therefore as required in the current manual of survey instructions of the United States Department of the Interior, Bureau of Land Management or by a decree of a Court of Law and for that the corner points mentioned in lines 3, 4 and 5 above were in conformance with the rules of the Michigan Board of Land Surveyors or by a Decree of a Court of Law; established, re-established, monumented, recovered, found as expressed below:

NOTE: Not more than 2 corners, all in the same town and range, may be recorded on this certificate.

A. Description of original monument and accessories and/or subsequent restoration:

1823 GLO Set post and two (2) accessories
Dec. 17, 1941 GEI Survey for Argonaut Realty Company
Jan. 8, 1955 GEI Survey for Argonaut Realty Division

B. Description of corner evidence found and/or method applied in restoring or reestablishing corner:

Found distance E-5 to F-5 and angle E-4, E-5, F-5 from December 17, 1941 GEI survey; Found distance E-5 to F-5 and established the SE corner of the NE 1/4 of the NW 1/4.

The method used to re-establish the corner was ratified by the Genesee County Peer Review Committee on December 18, 1997, as the accepted location.

C. Description of monument for corner and accessories established to perpetuate locating the position of the corner:


At the standard Bernsten monument SS-A-5-BR-30 with 3 1/4" brass cap stamped Genesee County Re-monumentation Corner 1997, #29242 in blacktop in concrete mortar.

N 25° E, 56.31' - South corner of the concrete base of a light pole
S 70° E, 28.16' - Southwest rim of a round catch basin in pavement
S 65° W, 102.95' - Northeast corner of the concrete base of a light pole
N 70° E, 313.0' - West edge of concrete base of water tower

Ratified by Peer Group in accordance with P.A. 345, 1990

Co. Rep. Carl Carlson
Date 12-18-97

Signed by Kevin Banfield Cleaver
Kevin Banfield Cleaver, P.S.,
Field Manager

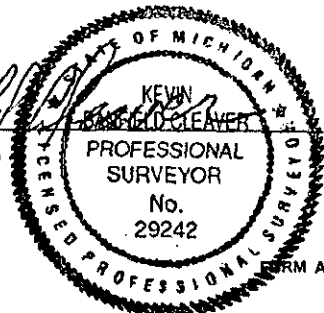

Date 12/24/97

Surveyor's Michigan License No. 29242

FORM APPROVED BY MICHIGAN STATE BOARD OF PROFESSIONAL SURVEYORS, JAN. 28, 1971

REVISED MAY 14, 1975

REVISED JAN., 1983 REVISED OCT., 1995