

RECORDED
Dec 23 11 33 AM '97


1997 REMONUMENTATION PROGRAM
LAND CORNER RECORDATION CERTIFICATE
Filing Requirement of Act 74, Mich. P.A. 1970

For corners in

Genesee (County)	Located In:	Cornor Code #
1. Public Land Survey	T 6N R 7E	G-5
	T R	
	T R	
2. Property Controlling In Section	S T R	
	S T R	
3. Miscellaneous Property in Sec.	S T R	
	S T R	

GENESEE COUNTY

Go filed over
Register of Deeds Stamp & File Number

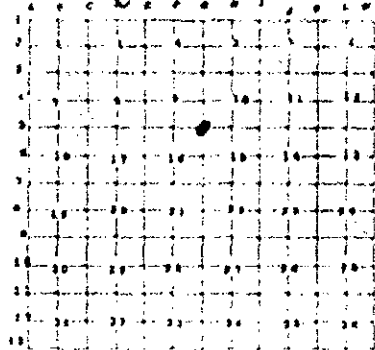

- 4. Lot No. _____, Recorded Plat _____
- 5. Private Claims _____

I, Kevin B. Cleaver, in a field survey on December 8, 1997, do hereby state that under requirements of P.A. 74, Michigan P.A. of 1970, the corner points mentioned in lines 1 and 2 above were in conformance with regulations and rules therefore as required in the current manual of survey instructions of the United States Department of the Interior, Bureau of Land Management or by a decree of a Court of Law and /or that the corner points mentioned in lines 3, 4 and 5 above were in conformance with the rules of the Michigan Board of Land Surveyors or by a Decree of a Court of Law, established, re-established, monumented, recovered, found as expressed below.

NOTE: Not more than 2 corners, all in the same town and range, may be recorded on this certificate.

A. Description of original monument and accessories and/or subsequent restoration:

- 1823 GLO Set post and two accessories
- March 6, 1943 GCRD Recorded Plat of "Assessor's Plat No. 1" L 17 P 53, 54 and 55 - Found Concrete Monument
- Jan. 20, 1950 Recorded plat of "LeFave Acres" L 22, P 46 - Found Concrete Monument
- Aug. 25, 1986 LCRC, L 2268, P 591 - Found "T" Iron, four (4) accessories
- Dec. 3, 1993 Found "T" Iron in gravel drive, four (4) accessories

Ratified by Peer Group in accordance with P.A. 345, 1990

Co. Rep. Carl Carlson
Date 12-11-97

B. Description of corner evidence found and/or method applied in restoring or reestablishing corner:

Found "T" Iron in Gravel

Found plat monumentation in the recorded plat of "Assessor's Plat No. 1" L 17 P 53 - 55 March 6, 1943; Found plat monumentation in the recorded plat of "LeFave Acres" L 22 P 46 January 20, 1950; Found four (4) accessories from August 25, 1986 LCRC L 2268 P 591; Found four (4) accessories in December 3, 1993 GEI records.

The monument found was ratified by the Genesee County Peer Review Committee on December 11, 1997, as the accepted corner.

C. Description of monument for corner and accessories established to perpetuate locating the position of the corner:

Set the standard Bernsten monument SS-A-5-BR-30 with 3 1/2" brass cap stamped Genesee County Re-monumentation Corner 1997, #29242 over a "T" Iron.

- East, 9.10' - Found Concrete Monument
- North, 38.15' - Found Nail and Tag in the West face of a 24" oak
- S 20° W, 38.40' - Found Southeast Corner of House #126
- N 45° W, 63.13' - Set nail and Genesee County witness tag in the Northeast face of a 15" pine

SURVEY & REMONUMENTATION

MAR 05 1998

SECTION

Signed by Kevin Banfield Cleaver
Kevin Banfield Cleaver, P.S.,
Field Manager

Date 12/24/97



Surveyor's Michigan License No. 29242

FORM APPROVED BY MICHIGAN STATE BOARD OF PROFESSIONAL SURVEYORS, JULY 26, 1971

REVISED MAY 14, 1972

REVISED JAN, 1983 REVISED OCT, 1986

