

SURVEY & REMONUMENTATION

MAR 05 1998

MASTER LIBER 3685 PAGE 948

SECTION

RECORDED

REGISTERED

DEC 29 11 33 AM '97

**1997 REMONUMENTATION PROGRAM
LAND CORNER RECORDATION CERTIFICATE
Filing Requirement of Act 74, Mich. P.A. 1970**

For corners in

<u>Genesee</u> (County)	Located In:	Corner Code #
1. Public Land Survey	T <u>6N</u> R <u>7E</u>	<u>K-4</u>
	T _____ R _____	_____
	T _____ R _____	_____
2. Property Controlling in Section	S _____ T _____ R _____	_____
	S _____ T _____ R _____	_____
3. Miscellaneous Property in Sec.	S _____ T _____ R _____	_____
	S _____ T _____ R _____	_____
4. Lot No. _____, Recorded Plat _____		
5. Private Claims _____		

GENESEE COUNTY REGISTERED

900 filed rec
Register of Deeds Stamp & File Number

	A	B	C	D	E	F	G	H	I	J	K	L	M
1													
2	6		5		4		3		2		1		
3													
4	7		8		9		10		11		12		
5													
6	18		17		16		15		14		13		
7													
8	19		20		21		22		23		24		
9													
10	30		29		28		27		26		25		
11													
12	31		32		33		34		35		36		
13													

I, Kevin B. Cleaver, in a field survey on November 10, 19 97 do hereby state that under requirements of P.A. 74, Michigan P.A. of 1970, the corner points mentioned in lines 1 and 2 above were in conformance with regulations and rules therefore as required in the current manual of survey instructions of the United States Department of the Interior, Bureau of Land Management or by a decree of a Court of Law and/or that the corner points mentioned in lines 3, 4 and 5 above were in conformance with the rules of the Michigan Board of Land Surveyors or by a Decree of a Court of Law, established, re-established, monumented, recovered, found as expressed below:

NOTE: Not more than 2 corners, all in the same town and range, may be recorded on this certificate.

A. Description of original monument and accessories and/or subsequent restoration:

- 1823 GLO Set post and two (2) accessories
- Dec. 29, 1966 CPCo
- Oct. 6, 1979 Certified survey, L 2361 P 433 - Found 'T' Iron at Fence Corner, four (4) accessories
- Nov. 28, 1979 GCRD Certified survey, L 2074 P 171 - Found 'T' Iron at NE Corner of Survey
- Jan. 15, 1980 GCRD LCRC, L 2074 P 168 - 'T' Iron at Fence Corner, three (3) accessories
- April 15, 1994 Certified Survey, L 2578, P 392 and 393, - Found 'T' Iron, five (5) accessories
- Dec. 20, 1996 GCRD Recorded condominium of "Water's Edge Condominium Plan No 82A",

B. Description of corner evidence found and/or method applied in restoring or reestablishing corner:

Found 'T' Iron

Found distance K-4 to K-3 from December 29, 1966 C.P.Co. records; Found one (1) accessory and distance K-4 to West Line of the East 1/2 of the Northeast 1/4 from October 6, 1979 survey L 2361 P 433; Found one (1) accessory from November 28, 1979 survey L 2074 P 171; Found one (1) accessory from January 15, 1980 LCRC L 2074 P 168; Found five (5) accessories, distances K-4 to K-5 and K-4 to Centerline Belsay Road and angle K-4, K-5, L-5 from April 15, 1994 survey L 2578 P 392 - 393; Found distance K-4 to Centerline of Belsay Road from the recorded condominium of "Water's Edge Condominium Plans No. 82A".

The monument found was ratified by the Genesee County Peer Review Committee on November 13, 1997, as the accepted corner.

C. Description of monument for corner and accessories established to perpetuate locating the position of the corner:

Set the standard Bernstein monument SS-A-5-BR-30 with 3 1/4" brass cap stamped Genesee County Re-monumentation Corner 1997, #29242 over a 'T' iron.


- North, 14.95' - Found Nail and Tag in an Elm
- South, 65.22' - Found Nail and Tag in the West face of a 15" tree
- S 45° W, 17.28' - Found Nail and Tag in the Southeast face of an 8" stump
- West, 5.88' - Found Nail and Tag in the South face of a 12" tree

Ratified by Peer Group in accordance with P.A. 345, 1990
Co. Rep. Carl Carlson
Date 11-13-97

Signed by Kevin Banfield Cleaver
Kevin Banfield Cleaver, P.S.
Field Manager

Date 12/24/97

Surveyor's Michigan License No. 29242

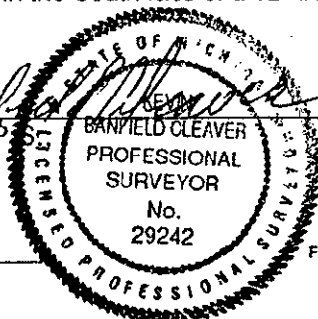

FORM APPROVED BY MICHIGAN STATE BOARD OF PROFESSIONAL SURVEYORS, JAN. 28, 1971

REVISED MAY 14, 1975

REVISED JAN., 1983 REVISED OCT., 1985