

SURVEY & REMONUMENTATION

MAR 23 2000

SECTION

**1999 GENESEE COUNTY REMONUMENTATION PROGRAM
LAND CORNER RECORDATION CERTIFICATE
Filing Requirement of Act 74, Mich. P.A. 1970**

MASTER LIBER 4355 PAGE 122

For corners in

Genesee (County)	Located In: Grand Blanc	Corner Code #
1. Public Land Survey	T6N R7E	K-13
	T R	
	T R	
	T R	
2. Property Controlling in Section	S T R	
	S T R	
3. Miscellaneous Property in Sec.	S T R	
	S T R	

GENESEE COUNTY REGISTER OF DEEDS
DEC 21 3 10 PM '99
109090
Filed & Rec 9:00
Register of Deeds Stamp & File Number

4. Lot No. _____, Recorded Plat _____
5. Private Claims _____

I, Kevin B. Cleaver, in a field survey on December 2, 1999, do hereby state that under requirements of P.A. 74, Michigan P.A. of 1970, the corner points mentioned in lines 1 and 2 above were in conformance with regulations and rules therefore as required in the current manual of survey instructions of the United States Department of the Interior, Bureau of Land Management or by a decree of a Court of Law and /or that the corner points mentioned in lines 3, 4 and 5 above were in conformance with the rules of the Michigan Board of Land Surveyors or by a Decree of a Court of Law; established, re-established, monumented, recovered, found as expressed below:

NOTE: Not more than 2 corners, all in the same town and range, may be recorded on this certificate.

	A	B	C	D	E	F	G	H	I	J	K	L	M
1													
2	6			5		4		3		2		1	
3													
4	7			8		9		10		11		12	
5													
6	18			17		16		15		14		13	
7													
8	19			20		21		22		23		24	
9													
10	30			29		28		27		26		25	
11													
12	31			32		33		34		35		36	
13													

A. Description of original monument and accessories and/or subsequent restoration:

- 1815 General Land Office (GLO) fieldnotes: set post w/one accessory
- 1823 GLO fieldnotes: closing corner measurement
- Undated Genesee County Road Commission (GCRC) records: measurement to section corner
- 10/73 Land Corner Recordation Certificate (LCRC), Liber 6203, Page 431: closing corner and half-mile measurements
- 10/23/73 LCRC, Liber 1872, Page 827: re-rod w/two accessories
- 4/4/91 P.A. 132 Certified Survey, Unrecorded: rod w/four accessories and half-mile measurements

B. Description of corner evidence found and/or method applied in restoring or reestablishing corner:

- GLO corner and accessory not found
- Confirmed within acceptable tolerance 1823 GLO closing corner measurement
- Did not confirm undated GCRC measurement to section corner
- Recovered corners and measured distances from 1973 LCRC
- Recovered corner and one accessory from 10/23/73 certified survey
- Recovered corner, four accessories, and confirmed half-mile measurement from 1991 certified survey

This monument found was ratified by the Genesee County Remonumentation Peer Review Committee on December 1, 1999.

C. Description of monument for corner and accessories established to perpetuate locating the position of the corner:

Set 3 1/4" brass cap stamped "Genesee County Remonumentation Corner, 1999, #29242" on top of concrete monument.


- N 19° W 30.55' nail & flagging in west face of 10" ash
- N 05° E 7.75' nail & flagging in west face of 7" maple
- S 17° E 24.47' nail & flagging in west face of 7" ash
- N 71° W 35.63' nail & flagging in northeast face of 12" ash
- S 75° W 14.85' nail & Delta tag in multiple 10"-12" dead trees

Ratified by Peer Group in accordance with P.A. 345, 1990

Co. Rep. Carl Carlson

Date 12-1-99

Signed by Kevin B. Cleaver
Surveyor's Michigan License No. _____

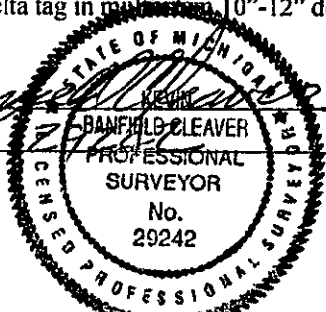

Date 12/21/99