


**SURVEY &  
REMONUMENTATION**

MAR 05 1998

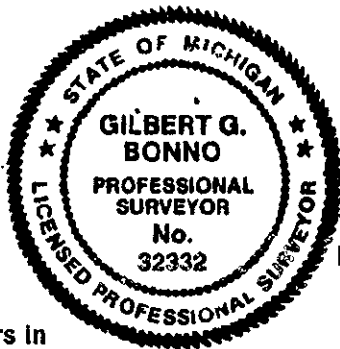

MASTER INDEX 3644 PAGE 669

SECTION

**1997 REMONUMENTATION PROGRAM  
LAND CORNER RECORDATION CERTIFICATE**  
Filing Requirement of Act 74, Mich. P.A. 1970

For corners in

Genesee Located In: Atlas Corner Code # C-4  
(County)

- |                                    |             |             |             |
|------------------------------------|-------------|-------------|-------------|
| 1. Public Land Survey              | T <u>6N</u> | R <u>8E</u> | C- <u>4</u> |
|                                    | T _____     | R _____     | _____       |
|                                    | T _____     | R _____     | _____       |
|                                    | T _____     | R _____     | _____       |
| 2. Property Controlling In Section | S _____     | T _____     | R _____     |
|                                    | S _____     | T _____     | R _____     |
| 3. Miscellaneous Property in Sec.  | S _____     | T _____     | R _____     |
|                                    | S _____     | T _____     | R _____     |
4. Lot No. \_\_\_\_\_ Recorded Plat \_\_\_\_\_  
5. Private Claims \_\_\_\_\_
- Ratified by Peer Group in accordance with P.A. 345, 1990  
Co. Rep. Callahan  
Date 9-11-97

RECORDED  
OCT 30 3 36 PM '97  
GENESEE COUNTY  
REGISTER OF DEEDS

Register of Deeds Stamp & File Number

	A	B	C	D	E	F	G	H	I	J	K	L	M
1													
2	6	5	4	3	2	1							
3													
4	7	8	9	10	11	12							
5													
	18	17	16	15	14	13							
	19	20	21	22	23	24							
10	30	29	28	27	26	25							
11													
12	31	32	33	34	35	36							
13													

I, Gilbert G. Bonno, P.S., in a field survey on July 10, 1997 do hereby certify that under requirements of P.A. 74, Michigan P.A. of 1970, the corner points mentioned in li ) 1 and 2 above were in conformance with regulations and rules therefore as required in the current manual of survey instructions of the United States Department of the Interior, Bureau of Land Management or by a decree of a Court of Law and/or that the corner points mentioned in lines 3, 4 and 5 above were in conformance with the rules of the Michigan Board of Land Surveyors or by a Decree of a Court of Law; established, re-established, monumented, re-monumented, recovered, found as expressed below:

NOTE: Not more than 4 corners, all in the same town and range, may be recorded on this certificate.

**A. Description of original monument and accessories and/or subsequent restoration:**

- 1823, GLO J. Wampler DS, set post and 2 accessories.
- 1912, GCRC - road plans, Perry Road, Geo A. Meade Co., Highway Engineer, iron pin, stone & crockery, plan shows cor. 11 1/2' N. of C/L Perry Rd., no accessories.
- 1919, GCRC Field notes, Irish Road, iron pin & brick and 3 new accessories.
- 1922, GCRC - Field notes & plans - Irish Road, no description of monument, no accessories given, field book shows corner at C/L-C/L Irish & Perry Roads. Fence lines W & S of corner, corner 27.14' W. of P.I.
- 1920's-1930's, GCRC - witnesses, iron pin and 3 new accessories.
- 1929-1930, GCRC - field notes & road plans - Perry Road, no desc. of monument, distance C-4 to D-4, field book sketch shows corner C/L-C/L Irish & Perry Roads, cor. 31.78' W. of P.I., dist. C-4 to D-4.

(Cont'd on back)

**B. Description of corner evidence found and/or method applied in restoring or reestablishing corner:**

1997 - Found 1/2" rod in a monument box above an iron pin and 1 accessory from 1988 (sanitary MH to west at 13.10').

An Iron Pin has been monumenting the position of C-4 since 1912 when Mr George A Meade Co. Hwy Eng. first reported finding an Iron Pin, Stone & Crockery at C-4. The monument remained an Iron Pin or Iron Bar (1960 GCRC) until 1978 when a 1/2 " rod in a monument box was found. The 1/2 mile measurement between the corners C-4 and C-3 was measured three times by the GCRC over a 40 year time period. The 1960 measurement was 2636.61' (39.95 ch) which was only 0.13' different than the 1939 measurement, and 0.39' from the 1922 measurement, and by 5 links from the 1823 GLO. In 1912 Perry Road was probably gravel and much narrower. Over the past 85 years the intersection has changed much in appearance and been widened several times as demonstrated by the different centerline call distances of 11 1/2' (1912), 44.3' (1939), 44.4' (1960), 44.2' (1988), and currently 42.6' (1997) which is within 1.8' of the 1939-1988 call distances. I recovered the same 1/2 " rod in a monument box that was first noted in 1978. Beneath the 1/2 " rod in the monument box we recovered an Iron Pin which I believe dates back to the 1912 survey by George A Meade. I was unable to remove the Iron Pin from the monument box to continue searching for either the brick (1919), or a stone & crockery (1912). No County Surveyors record of this corner was recovered during research, but stones, crockery and bricks were typical monumentation set by County Surveyors practicing in this area during the mid to late 1800's. I accept this corner to be a careful and faithful perpetuation of the position of the original corner.

**C. Description of monument for corner and accessories established to perpetuate locating the position of the corner:**

- |  |   |
|--|---|
| West 13.10' Sanitary MH (Center)                             | Ratified by Genesee County Peer Group September 11, 1997.   |
| N81W 34.38' Found 60D Spike in P/P                           |   |
| S61E 128.20' Found Nail & Tag "KRC" in 12" Elm               | I set the Standard Bemtsen Monument SS-A-5-BR-30 (3 1/4" D. Brass cap stamped "Genesee County Remonumentation Corner 32332, 1997") with 30" x 2 3/8" O.D. stainless steel tube in monument box. |
| S20° 34.11' Found Nail & Tag "KRC" in 10" of Twin Box Elders |   |
| S41° 146.40' Found Nail & Tag "KRC" in N Fc 12" Maple        |   |
| South 96.13' Found Gould Engineering "T" Iron                |   |


74762

Signed by Gilbert G. Bonno Date 9/11/97  
Surveyor's Michigan License No. 32332

SURVEY &  
REMONUMENTATION

MAR 05 1998

SECTION

 

MASTER  
LIBER 3644 PAGE 670

A. Cont'd.

- 1978, Gould Engineering witnesses, fnd rerod in mon. box and 1 new accessory.
- 1939, GCRC - Field notes & road plans - Irish Rd., no desc. of mon. given, field book sketch shows cor. 44.3' N of C/L Perry Rd.
- 1960, GCRC - field notes & witnesses, iron bar and 4 new accessories, Dist. C-4 to C-3.
- 1966, CPCo Survey - Dwg #S-F16879, symbol for fnd cor., no accessories given.
- 1978, Certified Survey, L.2007, P.986-987, LCRC L.2034, P.423, both by Jan S. Fokens, PS #21567, found "+" top of unopenable mon. box and 4 new accessories.
- 1987, Certified Survey, L.2284, P.786, A. Vance Kupisch PS #13586, fnd rerod in mon. box and 1 new accessory.
- 1988, Certified Survey, L.2355, P.700-702, LCRC L.2355, P.703, both by Gilbert Bonno PS #32332, fnd 1/2" rebar in mon. box and 1 new accessory.
- 1994, Unrecorded survey, Carl Carlson, PS #9189, fnd 1/2" rod in mon. box, accessories same as 1978 Jan S. Fokens, PS #21567, LCRC L.2034, P.423.
- 1997, Flint Surveying Witnesses, fnd 1/2" rerod in mon. box at C/L Rd. to N. and at Rd. from E. extended 42' N of C/L Perry Rd. E-W.