

SURVEY & REMONUMENTATION

MAR 05 1998

**1997 REMONUMENTATION PROGRAM
LAND CORNER RECORDATION CERTIFICATE**
Filing Requirement of Act 74, Mich. P.A. 1970

RECORDED
NOV 12 12 05 PM '97
REGISTERED

SECTION

For corners in

Genesee (County)	Located In: ATLAS	Corner Code # F-5
1. Public Land Survey	T <u>6N</u> R <u>8E</u>	<u>F-5</u>
	T _____ R _____	_____
	T _____ R _____	_____
	T _____ R _____	_____
2. Property Controlling in Section	S _____ T _____ R _____	_____
	S _____ T _____ R _____	_____
3. Miscellaneous Property in Sec.	S _____ T _____ R _____	_____
	S _____ T _____ R _____	_____

9.00 Filed & recorded
Register of Deeds Stamp & File Number

4. Lot No. _____, Recorded Plat _____
5. Private Claims _____
Ratified by Peer Group in accordance with P.A. 345, 1990
Co. Rep. Carl Larson
Date 11-6-97

	A	B	C	D	E	F	G	H	I	J	K	L	M
1													
2	6	5	4	3	2	1							
3													
4	7	8	9	10	11	12							
5													
6	18	17	16	15	14	13							
7													
8	19	20	21	22	23	24							
9													
10	30	29	28	27	26	25							
11													
12	31	32	33	34	35	36							
13													

I, Gilbert G. Bonno, P.S., in a field survey on _____ 19 97, do hereby certify that under requirements of P.A. 74, Michigan P.A. of 1970, the corner points mentioned in lines 1 and 2 above were in conformance with regulations and rules therefore as required in the current manual of survey instructions of the United States Department of the Interior, Bureau of Land Management or by a decree of a Court of Law and/or that the corner points mentioned in lines 3, 4 and 5 above were in conformance with the rules of the Michigan Board of Land Surveyors or by a Decree of a Court of Law; established, re-established, monumented, re-monumented, recovered, found as expressed below:

NOTE: Not more than 4 corners, all in the same town and range, may be recorded on this certificate.


A. Description of original monument and accessories and/or subsequent restoration:
1823, GLO - J. Wampler, DS; set post and 2 accessories, measured between corners E-5 and F-5, and F-5 and G-5.
1848, County Surveyor Records, post, no new accessories.
1991, Certified Survey - L.2512, P.871 by C.H. Carlson, PS #9189, 1 1/2" pipe, 2 new accessories.

B. Description of corner evidence found and/or method applied in restoring or reestablishing corner:
1997 Remon - Found 1 1/2" pipe on top of bank ±9' W. of edge of water. Recovered remnants of old wire fence laying down, running N-S and W. We recovered 2 accessories from 1991 (tag in 13" Beech to west at 24.55' and tag in 10" Beech to NW at 45.40')
Between 1848 and 1991 there are no records of any survey work being done tying into F-5 recovered during my research. I traversed the South half of section 9 and the measurement between E-5 & F-5 = 2684.96' (40.68ch), GLO = 40.25ch and measured between F-5 & G-5 = 2602.71' (39.44ch), GLO = 40.25ch. I recovered remnants of old wire fence West of F-5 and tied it down in a couple locations, these points in the fence are 0.8' South and 1.2' North of a straight line between E-5 to F-5. The corner F-5 was 1.55' North of a straight line between corners E-5 to G-5. We recovered two accessories from 1991, a grown over nail & flagging to the S80W at 24.59M (24.55R) and to the N70W at 45.41M (45.40R). The corner object called for from the 1991 survey was also recovered, a 1 1/2" pipe. The pipe was removed and the ground was excavated in search of further corner evidence. I dug down +/- 3.5' and found nothing. Old wire fence running N-S and W of the corner was also recovered. I accept this corner as the best available evidence of the position of the original corner.

C. Description of monument for corner and accessories established to perpetuate locating the position of the corner:
S80W, 24.59' fnd grown over nail with flagging in N fc 9" Beech
" 24.61' set nail & Genesee County witness tag in N fc 9" Beech
N70W, 45.41' fnd grown over nail with flagging in SSW fc 8" Beech
" 45.33' set nail & Genesee County witness tag in SSW fc 8" Beech
" 10W, 32.03' set nail & Genesee County witness tag in E fc 16" W. Oak
S05E, 17.45' set nail & Genesee County witness tag in W. fc 18" W. Oak

Ratified by Genesee County Peer Group October 2, 1997.
I set the standard Bernsten Monument SS-A-5-BR-30 (3 1/4" D. Brass cap stamped "Genesee County Remonumentation Corner 32332, 1997") with 30" x 2 3/8" O.D. stainless steel tube with plastic base.

77520

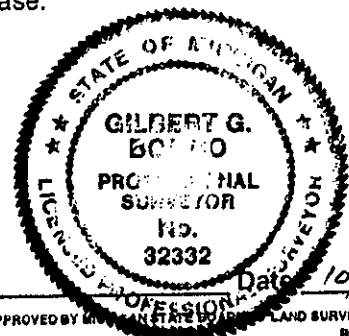

Signed by Gilbert G. Bonno
Surveyor's Michigan License No. 32332