


**SURVEY &  
REMONUMENTATION**

MAR 0-5 1998

SECTION

MASTER LIBER 3652 PAGE 716

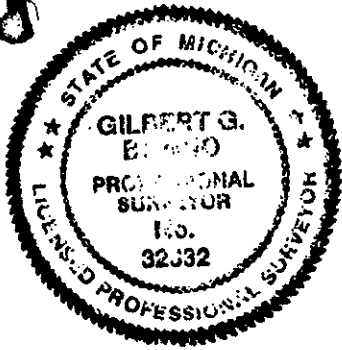

**1997 REMONUMENTATION PROGRAM  
LAND CORNER RECORDATION CERTIFICATE**  
Filing Requirement of Act 74, Mich. P.A. 1970

RECORDED  
NOV 12 12 05 PM '97  
REGISTERED

For corners in  
Genesee Located in: ATLAS Corner Code # G-5  
(County)

- |                                    |             |             |            |
|------------------------------------|-------------|-------------|------------|
| 1. Public Land Survey              | T <u>6N</u> | R <u>8E</u> | <u>G-5</u> |
|                                    | T           | R           |            |
|                                    | T           | R           |            |
|                                    | T           | R           |            |
| 2. Property Controlling in Section | S           | T           | R          |
|                                    | S           | T           | R          |
| 3. Miscellaneous Property in Sec.  | S           | T           | R          |
|                                    | S           | T           | R          |

9.00 filed & recorded  
Register of Deeds Stamp & File Number

4. Lot No. \_\_\_\_\_, Recorded Plat \_\_\_\_\_  
5. Private Claims \_\_\_\_\_  
Ratified by Peer Group in accordance with P.A. 345, 1990  
Co. Rep. Carl Carlson  
Date 10-2-97

	A	B	C	D	E	F	G	H	I	J	K	L	M
1													
2	6	5	4	3	2	1							
3													
4	7	8	9	10	11	12							
5													
6	18	17	16	15	14	13							
7													
8	19	20	21	22	23	24							
9													
10	30	29	28	27	26	25							
11													
12	31	32	33	34	35	36							
13													

I, Gilbert G. Bonno, P.S., in a field survey on July 12, 1997, do hereby certify that under requirements of P.A. 74, Michigan P.A. of 1970, the corner points mentioned in lines 1 and 2 above were in conformance with regulations and rules therefore as required in the current manual of survey instructions of the United States Department of the Interior, Bureau of Land Management or by a decree of a Court of Law and/or that the corner points mentioned in lines 3, 4 and 5 above were in conformance with the rules of the Michigan Board of Land Surveyors or by a Decree of a Court of Law; established, re-established, monumented, re-monumented, recovered, found as expressed below:

NOTE: Not more than 4 corners, all in the same town and range, may be recorded on this certificate.

- A. Description of original monument and accessories and/or subsequent restoration:**
- 1823, GLO - J. Wampler, DS; set post and 2 accessories.
  - 1849, County Surveyor - S. Beden CS; post and same 2 accessories, measured between corners G-5 and G-4.
  - 1950, GCRC - field notes & plans, no description of the monument given, no accessories given, drawing shows fence line to west, measured between corners G-5 and G-6, and G-5 and G-4.
  - 1982, Certified survey, L.2151, P.296 by Sheldon R. Brown PS #17613; found "T bar, 3 new accessories, measured between corners G-5 and H-5.
  - 1990, Certified Survey, L.2410, P.362-265, and LCRC, L.2410, P.357, both by Gilbert G. Bonno, PS #32332; found "T" iron, 4 new accessories, measured between corner G-5 and G-6.
  - 1991-1994, Certified surveys, L.2512, P.871-872 and L.2543, P.417-418, both by Carl H. Carlson, PS #9189; found "T" bar, same accessories as 1982 survey by S.R. Brown, measured between corners G-5 and G-6.

- B. Description of corner evidence found and/or method applied in restoring or reestablishing corner:**
- 1997 Remon - found bent "T" iron inside and above a 1" I.D. pipe ±1' below surface of gravel road, and 3 accessories from 1982 (oak to NE at 77.05', oak to NE at 85.05', and iron to W at 33.0'), and 2 accessories from 1990 (p/p to WSW at 78.98', and re-rod to E at 32.99').

In 1950 the GCRC, while performing a survey along Dutch Road showed a symbol for G-5 but had no description for it. At that time the County Surveyors measured 2647.51' between G-5 and G-4. This measurement differed by only 0.64' from my 1997 remon measurement, and 21 links different from the 1849 County Surveyor measurement. During my field research I recovered a bent "T" iron inside, and above a 1" I.D. pipe. Pipes were commonly used as monumentation by the Road Commission and a similar pipe was recovered and measured to at G-4. The small difference in measurement between 1950 and 1997, between G-5 and G-4, suggests that the found 1" I.D. pipe was possibly set by the Genesee County Road Commission. I possibly recovered two accessories from S.R. Brown PS#17613 (1982). Mr. Brown called out a 10" Oak to the NE at 77.05'(no desc. of object given), I measured 76.8' to the center of a 17" Elm. Mr. Brown also called out a 12" Oak to the ENE at 85.05'(no desc. of object given), I measured 83.9' to the center of a 18" Oak. I also recovered a tree row to the West of the corner with remnants of old wire fence laying down. The fence was shown on the GCRC DWG#389 for Dutch Rd. Upon review of this evidence; the half mile measurement between G-5 and G-4 and the tree row with old wire fence running West of G-5, I accept the position of the bent "T" iron above and inside a 1" I.D. pipe ±1' below the surface of the gravel road as a careful and faithful perpetuation of the position of the original corner.

- C. Description of monument for corner and accessories established to perpetuate locating the position of the corner:**
- East, 33.00' found rod & cap #9189
  - West, 33.00' found rod & cap #21578
  - S85W, 78.95' found nail & tag #32332 in NNE face P/P
  - N60W, 71.12' set nail & Genesee County witness tag in NE face 10" Red Pine

Ratified by Genesee County Peer Group October 2, 1997.  
I set the standard Bernsten Monument SS-A-5-BR-30 (3 1/4" D. Brass cap stamped "Genesee County Remonumentation Corner 32332, 1997") with 30" x 2 3/8" O.D. stainless steel tube over found 1" I.D. pipe ±0.05' below gravel surface of road.

Signed by Gilbert G. Bonno  
Surveyor's Michigan License No. 32332

Date 10/2/97