


72 DEC 2 4 33 PM '97

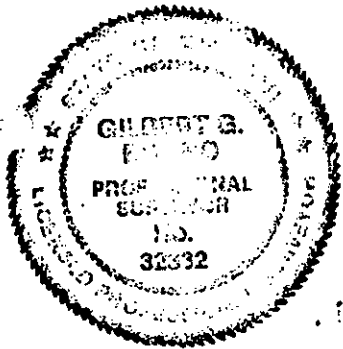

1997 REMONUMENTATION PROGRAM
LAND CORNER RECORDATION CERTIFICATE
Filing Requirement of Act 74, Mich. P.A. 1970

For corners in

Genesee (County) Located In: Atlas Corner Code #J-3
1. Public Land Survey T 6N R 8E J-3
2. Property Controlling In Section S T R
3. Miscellaneous Property in Sec. S T R

900 filed & rec
Register of Deeds Stamp & File Number

4. Lot No. Recorded Plat
5. Private Claims
Ratified by Peer Group in accordance with P.A. 345, 1980
Co. Rep. Carl Carlson
Date 10-30-97

Table with 13 rows and 13 columns (A-M) containing numbers 1-36 in a grid pattern.

I, Gilbert G. Bonno, P.S., in a field survey on July 25, 1997, do hereby certify that under requirements of P.A. 74, Michigan P.A. of 1970, the corner points mentioned in lines 1 and 2 above were in conformance with regulations and rules therefore as required in the current manual of survey instructions of the United States Department of the Interior, Bureau of Land Management or by a decree of a Court of Law and/or that the corner points mentioned in lines 3, 4 and 5 above were in conformance with the rules of the Michigan Board of Land Surveyors or by a Decree of a Court of Law; established, re-established, monumented, re-monumented, recovered, found as expressed below:

NOTE: Not more than 4 corners, all in the same town and range, may be recorded on this certificate.

A. Description of original monument and accessories and/or subsequent restoration:

- 1823, GLO - J. Wampler, DS; set post and 2 accessories, measured J-3, I-3 and J-3, K-3 39.50 chains.
Sept. 1921, GCRC - no description of monument and no accessories J-3, I-3 2580.4, J-3, K-3, 2594.6.
Nov. 1939, GCRC - no description of monument, no accessories J-3, I-3 2580.4, J-3, K-3 2593.7.
1920's-1930's, GCRC - 6 accessories, no description of monument.
1934, GCRC - no description and no accessories J-3, J-2 2697.8.
June, 1966, CPCo - set nail, 3 accessories, J-3, I-3 2581.26; J-3, K-3 2592.88; J-3, J-2 2697.90.
July, 1973, Certified survey - Carl Carlson L.1896, P.26-27, 3 accessories, no description of monument.
1973, CPCo Survey - Found PK nail, 4 accessories, J-3, I-3 2581.26; J-3, K-3 2592.88; J-3, J-2 2697.90.
March, 1974, Certified survey - Glen Fauser, L.1889, P.575-576, found nail, 3 accessories.
Jan., 1980, Certified survey - Paul E. Pangus, L.2082, P.789, fnd 5/8 re-rod in mon. box, 3 accessories J-3, I-3 2582.05; J-3, J-2 2698.20.
Sept., 1993, LCRC - L.2511, P.30-31, Grand Ward found 1/2" iron rod in mon. box, 4 accessories.
March, 1997, Unrecorded survey - Charles T. Lillieberg, no description, monument, 4 accessories.
March, 1997, Flint Surveying - witnesses, fnd 1/2" rod in mon. box 2.7 south of C.L. E-W bit. Road @ C.L. gravel road to north and old fence line south, 8 accessories listed.

B. Description of corner evidence found and/or method applied in restoring or reestablishing corner:

1997 Remon - Found 3/4" x 10" rod (looks like 1/2" rod on top) in monument box +/- 2.5' South of C/L Hill Rd. and at C/L gravel rd. to the North and a fallen down old wood anchor post to the South with old wire fence laying down running South. Measured between corners I-3 & J-3 = 2581.13' and J-3 & K-3 = 2592.34' and Angle right between I-3, J-3 and K-3 = 177°39'29"

In my field investigation I measured down Hill Rd., between M-15 and Washburn Rds.. The 1997 Remon measurement between I-3 & J-3 was 0.7' long of the 1921 GCRC measurement and between J-3 & K-3 it was 2.3' short of the 1921 GCRC measurement. The 1997 Remon angle and the 1921 GCRC angle between I-3, J-3 & K-3 were within 00°00'29". I recovered a laying down old wood anchor post to the South +/- 33'. A nail in a A. post was called for in the 1920's-1930's GCRC witnesses to the South at 33.55'. Despite numerous previous (older) accessories, the earliest recovered accessories were from 1993 and 1997(except the 1920's-1930's GCRC witness). All of the recovered accessories were within hundredths of a foot of record. After recovering the 3/4" rod, it was removed and the ground was excavated in search of further corner evidence. I dug down +/- 3' and found nothing. Upon review of this evidence; the 1/2 mile measurements and angle from J-3, and the recovered 3/4" x 10" rod (which I believe was set by the GCRC), and the recovered accessories, I accept this corner as a careful and faithful perpetuation of the position of the original corner.

C. Description of monument for corner and accessories established to perpetuate locating the position of the corner:

- N50W, 52.91' fnd spike & tag #22445 in SW fc cut off T. pole riser post
N50W, 52.87' fnd PK & flagging in SSW fc cut off T. pole riser post
South, 33.28' fnd 1/2" rod & cap #40162
South, 30.17' fnd spike & Delta tag in N fc Lt. Pole
South, 30.24' fnd PK in N fc Lt. Pole
South, 30.75' fnd spike & tag #22445 in E fc Lt. Pole
N35E, 57.02' fnd spike & tag #22445 in WNW fc 15" Pine
N45E, 44.88' fnd PK & flagging in SW fc 14" Pine
N55E, 48.59' fnd spike & tag #22445 in SE fc 14" Pine

Ratified by Genesee County Peer Group October 30, 1997.
I set the standard Bernsten Monument SS-A-5-BR-30 (3 1/4" D. Brass cap stamped "Genesee County Remonumentation Corner 32332, 1997") with 30" x 2 3/8" O.D. stainless steel tube set in monument box.

Signed by Gilbert G. Bonno
Surveyor's Michigan License No. 32332

Date 10/30/97

82487