


SURVEY & REMONUMENTATION

MAR 05 1998

MASTER LIBER 3644 PAGE 683

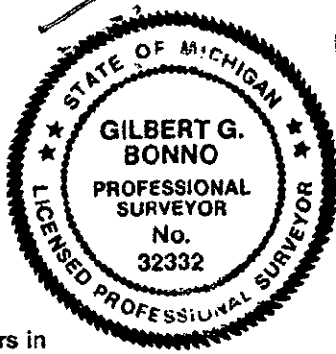

**SECTION
1997 REMONUMENTATION PROGRAM
LAND CORNER RECORDATION CERTIFICATE**
Filing Requirement of Act 74, Mich. P.A. 1970

RECORDED
MAY 30 3 37 PM '97
GENESSEE COUNTY

For corners in

Genesee Located In: Atlas Corner Code # K-5
(County)

- | | | | |
|------------------------------------|-------------|-------------|------------|
| 1. Public Land Survey | T <u>6N</u> | R <u>8E</u> | <u>K-5</u> |
| | T _____ | R _____ | _____ |
| | T _____ | R _____ | _____ |
| | T _____ | R _____ | _____ |
| 2. Property Controlling in Section | S _____ | T _____ | R _____ |
| | S _____ | T _____ | R _____ |
| 3. Miscellaneous Property in Sec. | S _____ | T _____ | R _____ |
| | S _____ | T _____ | R _____ |

4. Lot No. _____ Recorded Plat _____
5. Private Claims _____

Register of Deeds Stamp & File Number

I, Gilbert G. Bonno, P.S., in a field survey on July 22, 19 97, do hereby certify that under requirements of P.A. 74, Michigan P.A. of 1970, the corner points mentioned in lines 1 and 2 above were in conformance with regulations and rules therefore as required in the current manual of survey instructions of the United States Department of the Interior, Bureau of Land Management or by a decree of a Court of Law and/or that the corner points mentioned in lines 3, 4 and 5 above were in conformance with the rules of the Michigan Board of Land Surveyors or by a Decree of a Court of Law; established, re-established, monumented, re-monumented, recovered, found as expressed below:

	A	B	C	D	E	F	G	H	I	J	K	L	M
1													
2	6	5	4	3	2	1							
3													
4	7	8	9	10	11	12							
5	18	17	16	15	14	13							
	19	20	21	22	23	24							
10	30	29	28	27	26	25							
11													
12	31	32	33	34	35	36							
13													

NOTE: Not more than 4 corners, all in the same town and range, may be recorded on this certificate.

A. Description of original monument and accessories and/or subsequent restoration:

- 1823, GLO - J. Wampler DS, set post, and 2 accessories
- 1848, Julian Bishop CS, post, measured between corners K-5 & J-5, no new accessories.
- 1849, Julian Bishop CS, Post, measured between corners K-5 & K-6, no new accessories.
- 1869, S.R. Billings CS, stone 18" x 24"(US corner), 3 new accessories
- 1919, GCRC - field notes & road plans Coolidge Road, no description of monument given, measured between corners K-5 & L-5, and K-5 & J-5, no accessories given.
- 1937, GCRC - Henderson Road Field notes & road plans, no description of monument given, measured between corners K-5 & K-6, no accessories given, field note show corner 5' east of centerline Coolidge Road.
- 1920's - 1930's, GCRC - witnesses, fnd 1/2" pipe, 3 new accessories.
- 1964, Rowe Engineering - witnesses, fnd "T" iron, 1 new accessory.
- 1966, CPCo survey - Dwg #S-F16666, fnd "T" iron, measured between corners K-5 & K-6, K-5 & L-5, and K-5 & J-5, 2 new accessories.
- 1972, Certified Survey - L.1831, P.192-193 by B. Griggs Jr. PS #14763, no description of monument, no accessories given.
- 1974, LCRC - L.1893, P.965 by R. Mitchell P.S. #6936 found "T" bar, and 1 new accessory.
- 1991, Certified Survey - L.2428, P.133 by C. Carlson PS #9189, found "T" iron, no new accessories.
- 1991, witnesses - Gould Engineering, found "T" iron 8" below gravel, no new accessories.
- 1994, witnesses - Cornerstone Surveying, found "T", and 3 new accessories.

B. Description of corner evidence found and/or method applied in restoring or reestablishing corner:

- 1997 - Found "T" iron 1.8'± south of Coolidge Road and 5.5'± east of Henderson Road, above small pieces of brick and small pieces of wood (outside of wood appears to have been burned) and 3 accessories from 1966 (nail in T/P to north at 25.88', nail in 8" oak to WSW at 95.95' and nail in 8" cherry to SW at 111.10') and 1 accessory from 1974 (L/P to north at 24.95') and 1 accessory from 1991 (pk/cap in L/P to north at 24.98') and 3 accessories from 1994 (nail/tag #32332 in 18" ash to WSW at 95.90', nail/tag #32332 in U/P to SSE at 57.61' and nail tag #32332 in U/P to north at 24.71').
- (Cont'd on back)

C. Description of monument for corner and accessories established to perpetuate locating the position of the corner:

- North 24.20' Found Nail & Flagging in S Fc Light Pole
- 24.65' Found Nail & Tag # 32332 in E Fc Light Pole
- 24.67' Found Pk Nail & Disc in E Fc Light Pole
- S30E 57.62' Found Nail & Tag # 32332 in WSW Fc Utility Pole
- S20W 110.65' Found Nail & Gould Tag in E Fc 14" Cherry
- S75W 95.98' Found Nail & Gould Tag in S Fc 18" Ash
- 95.86' Found Nail & Tag # 32332 in N Fc 18" Ash
- N02W 25.55' Found Dbl Hd'd Nail in W Fc Cut Off Telephone Pole
- 25.46' Found Pk in S Fc Cut Off Telephone Pole

Ratified by Genesee County Peer Group September 11, 1997.

I set the Standard Berntsen Monument SS-A-5-BR-30 (3 1/4" D. Brass cap stamped "Genesee County Remonumentation Corner 32332, 1997") with a 30" x 2 3/8" O.D. stainless steel tube with plastic base

Ratified by Peer Group in accordance with P.A. 345, 1990

Co. Rep. [Signature] Date 9/11/97

Signed by Gilbert G. Bonno 9/11/97
Surveyor's Michigan License No. 32332

\$11.00 Filed & Paid

SURVEY &
REMONUMENTATION

MAR 05 1998

SECTION

MASTER
LIBER 3644 PAGE 684

B. (Cont'd)

During the 1920's-1930's the GCRC reported finding a 1/2 " Pipe monumenting the position of K-5. Three accessories were noted referencing the pipe. In 1964 Rowe reported a T Iron monumenting K-5. At that time two of the three GCRC witnesses were still present and indicate that the T Iron recovered in 1964 is in the same position as the 1/2 " Pipe recovered by the GCRC. Since 1964 the T Iron monumenting K-5 has remained and many further accessories have been recorded. I recovered the T Iron and many of the recorded accessories and from this gathered data conclude that the T Iron recovered in 1997 is the same T Iron recovered in 1964 which is in the same position as the 1/2 " Pipe found during the 1920's-1930's by the GCRC. Beneath the T Iron I recovered small pieces of brick and small pieces of charred wood and conclude that this is evidence of a monument set by a county surveyor approximately 100 years ago. During research I recovered three County Surveyors records of this corner. Two records (1848 & 1849 Julian Bishop CS) claimed to have had the GLO Post as the monument, and the third (1869 SR Billings CS) also claimed to have recovered evidence of the GLO corner and said that he further perpetuated the position with a Stone 18" x 24". No mention of setting brick was present in the recovered records, but brick was typical monumentation set by County Surveyors practicing in this area during the mid to late 1800's. I also conclude that the charred pieces of wood we recovered were most likely the remnants of a stake set by a County Surveyor. The wood was possibly burned to harden the stake and subsequently that charred portion is what survived. Upon review of this evidence I accept the position of the T Iron above small pieces of brick & charred wood as a careful and faithful perpetuation of the position of the original corner.