


DEC 2 4 33 PM '97

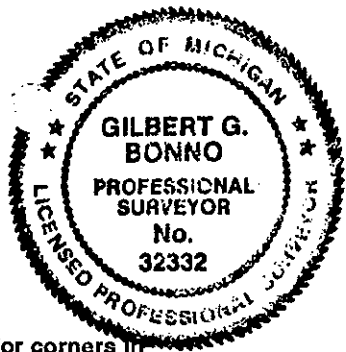

1997 REMONUMENTATION PROGRAM
LAND CORNER RECORDATION CERTIFICATE
Filing Requirement of Act 74, Mich. P.A. 1970

SURVEY & REMONUMENTATION

MAR 05 1998

SECTION

900 [Signature]
Register of Deeds Stamp & File Number

For corners in

Genesee Located In: Corner Code # L-3
(County)

- 1. Public Land Survey T 6N R 8E L-3
2. Property Controlling in Section S T R
3. Miscellaneous Property in Sec. S T R

4. Lot No. Recorded Plat Ratified by Peer Group in accordance with P.A. 345, 1990
5. Private Claims Co. Rep. Carl Carlson Date 10-30-97

I, Gilbert G. Bonno, P.S., in a field survey on July 25, 1997, do hereby certify that under requirements of P.A. 74, Michigan P.A. of 1970, the corner points mentioned in lines 1 and 2 above were in conformance with regulations and rules therefore as required in the current manual of survey instructions of the United States Department of the Interior, Bureau of Land Management or by a decree of a Court of Law and/or that the corner points mentioned in lines 3, 4 and 5 above were in conformance with the rules of the Michigan Board of Land Surveyors or by a Decree of a Court of Law; established, re-established, monumented, re-monumented, recovered, found as expressed below:

NOTE: Not more than 4 corners, all in the same town and range, may be recorded on this certificate.

Grid table with columns A-M and rows 1-13. Cell 2,6 contains '6', cell 2,5 contains '5', cell 2,4 contains '4', cell 2,3 contains '3', cell 2,2 contains '2', cell 2,1 contains '1'. Cell 3,6 contains a dot. Cell 4,1 contains '7', cell 4,2 contains '8', cell 4,3 contains '9', cell 4,4 contains '10', cell 4,5 contains '11', cell 4,6 contains '12'. Cell 5,1 contains '18', cell 5,2 contains '17', cell 5,3 contains '16', cell 5,4 contains '15', cell 5,5 contains '14', cell 5,6 contains '13'. Cell 6,1 contains '19', cell 6,2 contains '20', cell 6,3 contains '21', cell 6,4 contains '22', cell 6,5 contains '23', cell 6,6 contains '24'. Cell 7,1 contains '30', cell 7,2 contains '29', cell 7,3 contains '28', cell 7,4 contains '27', cell 7,5 contains '26', cell 7,6 contains '25'. Cell 8,1 contains '31', cell 8,2 contains '32', cell 8,3 contains '33', cell 8,4 contains '34', cell 8,5 contains '35', cell 8,6 contains '36'.

A. Description of original monument and accessories and/or subsequent restoration:
1823, GLO - J. Wampler, DS; set post and 2 accessories, measured between corners K-3 and L-3 and L-3 and M-3.
1865, County Survey Records - S. Matthewson CS, no description of monument given, no accessories given measured L-3 to M-3.
1921, GCRC - Field book #479 (Hill Rd.) No description of monument given, no accessories given, measured K-3 to L-3 and L-3 to M-3.
1922, MDOT - drawing #94 (Hill Rd.), no description of monument given, 3 new accessories.
1920's-1930's, GCRC - witnesses, stake, 1 new accessory.
1939-1940, GCRC - Field book and drawing #1005, no description of monument given, no accessories given, measured K-3 to L-3 and L-3 to M-3.
1971, LCRC - L.1838, P.167 by A.F. Miller PS #12024, bent R/R spike, 1 new accessory.
1972, LCRC - L.1838, P.220 and certified survey - L.1838, P.225 both by B. Henderson PS #16043, found iron pipe, no new accessories.
1978, Certified survey - L.2075, P.804 by c. Getz PS #25843, found monument box (no description of object), no new accessories, measured L-3 to M-3.

B. Description of corner evidence found and/or method applied in restoring or reestablishing corner:
1997 Remon - Found 1/4" x 10" rod in a monument box ±5.5' south of C/L Hill R. I recovered 2 accessories from 1920's-1930's (12" hickory to N at 84.8' and 30" oak to S. at 37.71') and 1 accessory from 1971 (20" oak at SE at 66.80').

In 1921, while performing a survey of Hill (Hadley) road, the GCRC shows a fence to the North and South of the corner. I recovered evidence of fence and tree rows to the North and South. The corner appears +/- 3.5' East of the tree row South and in line with tree row to North. I measured between K-3 & L-3 and differed by 5 links (3.3 feet) from 1823 GLO and 0.5 feet from 1921 GCRC. I also measured between L-3 & M-3 and differed by 3 links (1.98 feet) from 1823 GLO and 0.2 feet from 1921 GCRC. Three accessory trees (unable to recover specific objects in the trees) were recovered from 1920's - 1930's GCRC witnesses; North 84.8'(R) nail in 12" Hickory, measured 84.05' to find nail & tag #12024 in SE fc 22" Hickory; SE 67.08'(R) nail in 12" Oak, measured 67.26' to find nail & rusty disc in N fc 30" Oak; South 37.71' nail in 30" Oak, measured 36.69' to nail & Carlson tag #9189 in E fc 32" Oak. The same three trees are called for in 1971, 1972 and 1978 and the recorded measurements still measure to the same tree to date. The found 3/4" rod at L-3 was removed and the inside of the monument box was excavated in search of other corner evidence, no other monumentation evidence was recovered. Upon review of this evidence; fence and tree rows North and South, recovered accessories and the half mile measurements, I accept this corner as a careful and faithful perpetuation of the position of the original corner.

C. Description of monument for corner and accessories established to perpetuate locating the position of the corner:
S05W, 36.69' found nail & tag #9189 in E. fc 32" Oak
S05W, 36.29' found nail & electric fence insulator in N. fc 32" Oak (2)
S55E, 67.26' found nail & rusty disc in N. fc 30" Oak
North, 84.05' found nail & tag #12024 in SE fc 22" Hickory
40E, 37.50' set chiseled "X" in top of E. end 12" concrete culvert under drive to house #12267
Ratified by Genesee County Peer Group October 30 1997.
I set the standard Bernsten Monument SS-A-5-BR-30 (3 1/4" D. Brass cap stamped "Genesee County Remonumentation Corner 32332, 1997") with 30" x 2 3/8" O.D. stainless steel tube set in a monument box.

82489

10/30/97

Signed by Gilbert G. Bonno
Surveyor's Michigan License No. 32332

Date 10/2/97