


**SURVEY &  
REMONUMENTATION**

MAR 05 1998

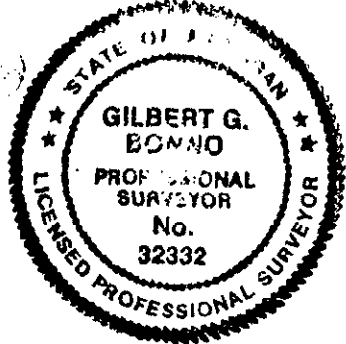

SECTION \_\_\_\_\_

MASTER LIGER 3652 PAGE 721

**1997 REMONUMENTATION PROGRAM  
LAND CORNER RECORDATION CERTIFICATE  
Filing Requirement of Act 74, Mich. P.A. 1970**

RECORDED  
NOV 12 12 05 PM '97  
REGISTER OF DEEDS

For corners in

Genesee (County)	Located In: ATLAS	Corner Code # L-5
1. Public Land Survey	T 6N R 8E	L-5
	T _____ R _____	_____
	T _____ R _____	_____
	T _____ R _____	_____
2. Property Controlling in Section	S _____ T _____ R _____	_____
	S _____ T _____ R _____	_____
3. Miscellaneous Property in Sec.	S _____ T _____ R _____	_____
	S _____ T _____ R _____	_____

9:00 filed & recorded  
Register of Deeds Stamp & File Number

4. Lot No. \_\_\_\_\_, Recorded Plat \_\_\_\_\_

5. Private Claims \_\_\_\_\_

	A	B	C	D	E	F	G	H	I	J	K	L	M
1													
2	6	5	4	3	2	1							
3													
4	7	8	9	10	11	12							
5													
6	18	17	16	15	14	13							
7													
8	19	20	21	22	23	24							
9													
10	30	29	28	27	26	25							
11													
12	31	32	33	34	35	36							
13													

I, Gilbert G. Bonno, P.S., in a field survey on 19 97, do hereby certify that under requirements of P.A. 74, Michigan P.A. of 1970, the corner points mentioned in lines 1 and 2 above were in conformance with regulations and rules therefore as required in the current manual of survey instructions of the United States Department of the Interior, Bureau of Land Management or by a decree of a Court of Law and/or that the corner points mentioned in lines 3, 4 and 5 above were in conformance with the rules of the Michigan Board of Land Surveyors or by a Decree of a Court of Law; established, re-established, monumented, re-monumented, recovered, found as expressed below:

NOTE: Not more than 4 corners, all in the same town and range, may be recorded on this certificate.

**A. Description of original monument and accessories and/or subsequent restoration:**

- 1823, GLO - J. Wampler, DS; set post and 2 accessories.
- 1849, County Surveyor, J. Bishop C.S., no description of monument given, no accessories given, measured between corners K-5 & M-5.
- 1869, County Surveyor, S.R. Billings C.S., set stone and brick and 1 accessory.
- 1919, GCRC, field notes and road plans, Coolidge Rd., no description of monument, fence to N., measured between corners K-5 and L-5, and L-5 ad M-5.
- 1966, H.W. Dorsey, Job #6806, set T-iron, 4 new accessories.
- 1980, Recorded survey L.2098, P.934, S.R. Brown PS #17613, no description of monument given, 3 new accessories.
- 1981, LCRC L.2126, P.327, E. Harris PS #9431, found T-iron, 5 new accessories.
- 1991, Certified survey, L.2428, P.133 C. Carlson PS #9189, found obliterated T-iron, reset iron and cap.
- 1996, Unrecorded survey, Davison L.S., C. Lillieberg PS #40162, found T-bar, 1 new accessory.

**B. Description of corner evidence found and/or method applied in restoring or reestablishing corner:**

1997 Remon - Found 1/2" rod with bashed cap, next to found smashed "T" iron with yellow top, next to found delapidated "T" iron. Beneath "T" iron with yellow top and 1/2" rod I recovered 5 fist sized stones, no brick or stone. Five accessories from 1981 (rod/cap #21578 to N. at 32.99', rod/cap #13763 to S. at 32.96', tag in tree to NE at 50.10, tag in 15' tree to NW at 69.24', tag in 14" tree to SE at 45.65').

In 1823 J. Wampler D.S. indicates a set post for corner L-5, then in 1869 S.R. Billings c.S. indicates a stone and brick. GCRC field notes of 1919 indicate measurements between K-5 to L-5 of 2616.8, deflection angle to the left of 1°5', also a measurement of L-5 to M-5 of 2605.25, deflection angles of 0°3' left. Their notes indicate not finding the stone, but show a fence line to the north. In a 1966 survey by Consumers Power Company. They indicate setting a "T" iron on line between section corners K-5 to M-5 with a fence line to the north and brush row to the south. They indicate 4 accessories of which we are finding 3 of them today checking within ±0.05 feet of the record measurement. Two measurements K-5 to L-5 of 2603.84 feet, L-5 to M-5 of 2610.04 feet, are indicated on the Consumer's survey. In 1981 Elbex Harris, P.S. # 9431 indicated finding a "T" iron at corner L-5. Five accessories are shown, I am finding all 5 today again checking within ±0.05 feet of record. This "T" iron continues to show up in various surveys from 1966 to the present. Today during the 1997 Remonumentation program I found a "T" iron next to a 1/2" re-rod. I dug down approximately 3 feet from the top of the "T" iron. Under the "T" and rod I found 5 stones about fist-size in a pile. I found no evidence of a stone typical of the size set by County surveyors or of the brick mentioned in the 1869 survey. I accept the position of the "T" (next to the rod), above the pile of 5 stones as the best available evidence of the original corner.

**C. Description of monument for corner and accessories established to perpetuate locating the position of the corner:**

- N40E, 27.67' fnd. double headed nail & plastic washer in SE fc
- 12" Locust
- S10W, 55.09' fnd. old PK & flagging in WNW fc P/P
- South, 32.93' fnd. Delta rod & cap #13763
- North, 32.99' fnd. rod & cap #21578
- N55E, 50.16' fnd. GE tag in S. fc 22" Locust
- N75E, 69.16' fnd. GE tag in S. fc 22" Locust
- S55E, 45.67' fnd. GE tag in NE fc 16" Locust
- S70W, 107.60' fnd. GE tag in N. fc 30" Oak

Ratified by Genesee County Peer Group October 2, 1997.  
I set the standard Bernsten Monument SS-A-5-BR-30 (3 1/4" D. Brass cap stamped "Genesee County Remonumentation Corner 32332, 1997") with 30" x 2 3/8" O.D. stainless steel tube with plastic base.

Ratified by Peer Group in accordance with P.A. 345, 1990 **77519**

Signed by Gilbert G. Bonno

Co. Rep. Carl Carlson

Date 10/2/97

Surveyor's Michigan License No. 32332

Date 11-6-97