

MAY 31 2000

**SECTION**

**1996 REMONUMENTATION PROGRAM  
LAND CORNER RECORDATION CERTIFICATE  
Filing Requirement of Act 74, Mich. P.A. 1970**

For corners in

Genesee (County)	Located In:	Corner Code #
1. Public Land Survey	T <u>7N</u> R <u>5E</u>	<u>B-5</u>
	T _____ R _____	_____
	T _____ R _____	_____
	T _____ R _____	_____
2. Property Controlling in Section	S _____ T _____ R _____	_____
	S _____ T _____ R _____	_____
3. Miscellaneous Property in Sec.	S _____ T _____ R _____	_____
	S _____ T _____ R _____	_____

RECORDED  
DEC 30 11 37 AM '96  
900

83532

FILED & RECORDED  
Register of Deeds Stamp & File Number

4. Lot No. \_\_\_\_\_, Recorded Plat \_\_\_\_\_  
5. Private Claims \_\_\_\_\_

	A	B	C	D	E	F	G	H	I	J	K	L	M
2	6	5	4	3	2	1							
3													
4	7	8	9	10	11	12							
5													
6	18	17	16	15	14	13							
7													
8	19	20	21	22	23	24							
9													
10	30	29	28	27	26	25							
11													
12	31	32	33	34	35	36							
13													

I, Kevin B. Cleaver, P.S., field survey on October 18, 19 96, do hereby certify that under requirements of P.A. 74, Michigan P.A. of 1970, the corner points mentioned in lines 1 and 2 above were in conformance with regulations and rules therefore as required in the current manual of survey instructions of the United States Department of the Interior, Bureau of Land Management or by a decree of a Court of Law and/or that the corner points mentioned in lines 3, 4 and 5 above were in conformance with the rules of the Michigan Board of Land Surveyors or by a Decree of a Court of Law; established, re-established, monumented, re-monumented, recovered, found as expressed below:

**NOTE: Not more than 4 corners, all in the same town and range, may be recorded on this certificate.**

A. Description of original monument and accessories and/or subsequent restoration:

- 1821, GLO Set post, with two (2) accessories
- Nov. 30, 1973 Certified survey, Liber 1857, page 13, found 1/2" rod, with three (3) accessories
- 1973 Gould Engineering, Inc. records, 1/2" re-rod, with three (3) accessories
- July 3, 1986 L.C.R.C., Liber 2305, page 497, found 1/2" re-rod, with three (3) accessories

B. Description of corner evidence found and/or method applied in restoring or reestablishing corner:

Found 1/2" re-rod in gravel road; found two (2) accessories from Nov. 30, 1973, survey in Liber 1857, page 13; found two (2) accessories from 1973 Gould Engineering, Inc. records; found two (2) accessories from July 3, 1986, L.C.R.C. Liber 2305, page 497.

The monument found was ratified by the Genesee County Peer Review Committee on October 9, 1996, as the accepted corner.

**Ratified by Peer Group in accordance with P.A. 345, 1990**


Co. Rep. Kevin Banfield  
Date 10-9-96

C. Description of monument for corner and accessories established to perpetuate locating the position of the corner:

Set the standard Bernsten monument SS-A-5-BR-30, with 3/4" brass cap stamped Genesee County Remonumentation corner 1996, #29242 over 1/2" re-rod in gravel road.

- S 05° E 34.05' Set remon. tag in the West face of 5" twin elm
- N 15° W 20.96' Set remon. tag in top of 3"x4" post of retaining wall
- N 35° W 85.27' Set remon. tag in Southwest face 14" maple
- S 40° E 28.45' Set remon. tag in Southwest face 4" elm
- South 26.60' Found top North face concrete post

Signed by Kevin Banfield Cleaver Date Oct 12 1996  
Surveyor's Michigan License No. 29242  
Kevin Banfield Cleaver, P.S., Its Field Manager

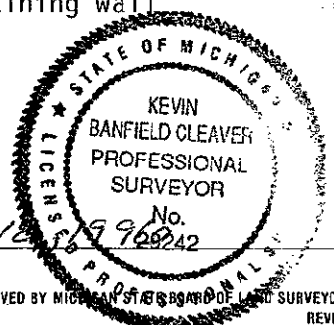

83