

REMONUMENTATION CORNER UNDER ACT 345, MICHIGAN PUBLIC ACTS OF 1990
LAND CORNER RECORDATION CERTIFICATE
Filing Requirement of Act 74, Mich. P.A. 1970

For corners in

GENESEE

Country

Located In:

Flint Twp

Corner Code #:

- 1. Public Land Survey T 7N R 6E B-3
- T R
- T R
- T R
- 2. Property Controlling S T R
- in Section S T R
- 3. Miscellaneous S T R
- Property in Sec. S T R

- 4. Lot No. Recorded Plat
- 5. Private Claims

RECORDED
Dec 27 9 11 AM '93
GENESEE COUNTY
FLINT MICHIGAN
77965
FILED & RECORDED
Register of Deeds Stamp & File Number

I, DONALD G. RICHARDS in a field survey on December 3, 19 93 do hereby certify that under requirements of P.A. 74, Michigan P.A. of 1970, the corner points mentioned in lines 1 and 2 above were in conformance with regulations and rules therefore as required in the current manual of survey instructions of the United States Department of the Interior, Bureau of Land Management or by a decree of a Court of Law and/or that the corner points mentioned in lines 3, 4 and 5 above were in conformance with the rules of the Michigan Board of Land Surveyors or by a Decree of a Court of Law, established, re-established, monumented, re-monumented, recovered, found as expressed below:

A	B	C	D	E	F	G	H	I	J	K	L	M
2												
3												
NOTE: Not more than 4 corners, all in the same town and range, may be recorded on this certificate.

A. Description of original monument and accessories and/or subsequent restoration:

Horatio Ball/Hervey C. Parke
Tuesday September 18th?, 1821
Lynn 10 N 54 W 4
Sugar 6 S 25 W 6
(see reverse side for additional information)


B. Description of corner evidence found and/or method applied in restoring or reestablishing corner:

Found Bolt in Monument Box

SURVEY &
REMONUMENTATION
MAR 16 1994
COMMISSIONER

C. Description of monument for corner and accessories established to perpetuate locating the position of the corner:

Set Bernsten monument SS-A5BR-30 stamped "Genesee County Remonumentation Corner" over Bolt in Monument Box
S 40 W 71.29' nail/GCWT* in E face Brick entryway fence
N 02 E 51.42' nail/GCWT in W face 12" Oak
N 45 E 113.09' nail/GCWT in NW face 17" Willow
S 40 E 76.36' nail/GCWT in E face Brick entryway fence
EAST 2687.76' section corner C-3, T7N-R6E
(* Genesee County Witness Tag)

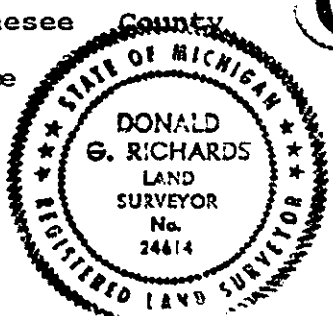

Signed by DONALD G. RICHARDS [Signature] Date December 10, 1993

Surveyor's Michigan License No. 24614
APPROVED by Genesee County Monumentation Peer Group 12-01-93

FORM APPROVED BY MICHIGAN STATE BOARD OF LAND SURVEYORS, JAN. 26, 1971
REVISED MAY 14, 1978
REVISED JAN., 1989

FLINT TOWNSHIP

GCRC TIES

No. 2: Stone
SW 39.8 nail in 40" Elm
SE 42.15 nail in 5" Pine
NE 63.95 nail in 24" Oak
NORTH 32.45 nail in anchor post

PA 74

pg 28 (1975/497 chmp) A.F. Miller 4-25-77
Found Bolt in Monument Box
S 60 W 133.37 nail/tag in power pole
NORTH 50.85 nail/tag in tele pole
N 25 E 56.13 3" cherry tree

PA 132 SURVEYS

2381/22-23

A.F. Miller 4-28-77
Found Bolt in Mon Box
S 60 W 133.37 nail/tag in power pole
NORTH 50.85 nail/tag in tele pole
N 25 E 56.13 3" Cherry tree

Carl H. Carlson 6-30-89
Found Bolt in Mon Box
same as above and PA 74 pg 28