

REMONUMENTATION CORNER UNDER ACT 345 MICHIGAN PUBLIC ACTS OF 1998
LAND CORNER RECORDATION CERTIFICATE
Filing Requirement of Act 74, Mich. P.A. 1970

RECORDED
REG. ST. 9 11 AM '93
GENESEE COUNTY
FLINT MICHIGAN
77966

For corners in

GENESEE

(County)

Located In:

Flint Twp

Corner Code 11

1. Public Land Survey	T	<u>7N</u>	R	<u>6E</u>	C-3
	T		R		
	T		R		
	T		R		
2. Property Controlling In Section	S		T	R	
	S		T	R	
3. Miscellaneous Property in Sec.	S		T	R	
	S		T	R	

Register of Deeds Stamp & File Number

- 4. Lot No. _____, Recorded Plat _____
- 5. Private Claims _____

I, DONALD G. RICHARDS, in a field survey on December 3, 19 93, do hereby certify that under requirements of P.A. 74, Michigan P.A. of 1970, the corner points mentioned in lines 1 and 2 above were in conformance with regulations and rules therefore as required in the current manual of survey instructions of the United States Department of the Interior, Bureau of Land Management or by a decree of a Court of Law and/or that the corner points mentioned in lines 3, 4 and 5 above were in conformance with the rules of the Michigan Board of Land Surveyors or by a Decree of a Court of Law, established, re-established, monumented, re-monumented, recovered, found as expressed below:

NOTE: Not more than 4 corners, all in the same town and range, may be recorded on this certificate.

A	B	C	D	E	F	G	H	I	J	K	L	M
2												
3												
A. Description of original monument and accessories and/or subsequent restoration:

Horatio Ball/Hervey C. Parke
Tuesday September 18th, 1821
W.O. 19 S 21 E 13
Sugar 7 N 30 W 31
(see reverse side for additional information)

B. Description of corner evidence found and/or method applied in restoring or reestablishing corner:


Found rered in Monument Box

SURVEY & REMONUMENTATION

MAR 16 1994
COMMISSION

C. Description of monument for corner and accessories established to perpetuate locating the position of the corner:

Set Bernsten monument SS-A5BR-30 stamped "Genesee County Remonumentation Corner" over rered in Monument Box
S 40 W 64.83' nail/GCWT* in S face 13" Pine
N 60 W 73.84' nail/GCWT in NE face power pole
N 45 E 67.47' nail/GCWT in NW face power pole
S 05 E 52.40' nail/GCWT in W face power pole
WEST 2687.76' quarter corner B-3, T7N-R6E
EAST 2675.87' quarter corner D-3, T7N-R6E
(* Genesee County Witness Tag)

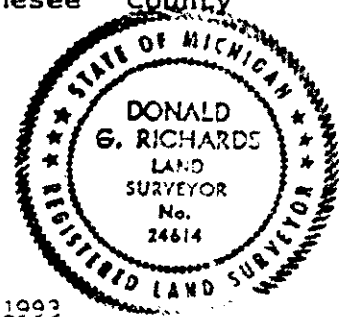

Signed by DONALD G. RICHARDS Date December 10, 1993

Surveyor's Michigan License No. 24614

APPROVED by Genesee County Monumentation Peer Group 12-01-93

GCRC TIES

No. 3: Stone, stake
SSW 40.0 6" Cherry
SE 44.7 24" Maple
NE 139.3 12" Maple
NW 85.6 SE cor of most E'ly wing of structure

PA 74

pg 2 (1826/866) Ralph Landini 5-17-72
Found Monument Box
Util Pole N 55 W 73.88
Util Pole N 45 E 67.11
Iron Post Due South 36.21

pg 15 (1881/884-885) Karol R. Piotrowski 2-27-74
Found 1/2" Rod in Monument Box
Steel sign N 45 W 76.20
Lamp Post S 35 W 83.65
Power Pole S 2 E 52.68

PA 132 SURVEYS

2129/326
1869/924 have Karol R. Piotrowski 7-10-73
Found 1/2" Rod in Monument Box
same as PA 74 pg 15 above

Karol R. Piotrowski 9-29-75
Found empty monument Box
N 55 W 73.88 Power Pole
N 45 E 67.11 Power Pole
SOUTH 36.21 base of Iron Post

A.F. Miller 4-28-77
Found Rerod in Mon Box
S 01 E 52.55 nail/tag in power pole
N 45 E 66.77 nail/tag in power pole
N 55 W 73.60 nail/tag in tele pole

A.F. Miller 6-27-79 (rev 8-21-79)
Found Empty Mon Box
N 55 W 73.88 Power pole
N 45 E 67.11 Power pole
Base of Iron Post SOUTH 36.21

A.F. Miller 10-16-79
Found empty Mon Box
PP N 55 W 73.88
PP N 45 E 67.11
Base of Iron Post SOUTH 36.21

Carl H. Carlson 6-30-89
Found rerod in Mon Box
S 51 E 52.55 nail/tag in power pole
N 45 E 66.77 nail/tag in power pole
N 55 W 73.60 nail/tag in tele pole

A.F. Miller 5-21-90
Found empty Mon Box
N 45 E 67.11 PP
SOUTH 36.21 base of iron post
N 55 W 73.88 PP