

REMONUMENTATION CORNER UNDER ACT 345, MICHIGAN PUBLIC ACTS OF 1990

LAND CORNER RECORDATION CERTIFICATE

Filing Requirement of Act 74, Mich. P.A. 1970

For corners in

GENESEE

(County)

Located In:

Corner Code -#

Flint Top

- 1. Public Land Survey T 7N R 6E D-3
- T _____ R _____
- T _____ R _____
- T _____ R _____
- 2. Property Controlling S _____ T _____ R _____
- in Section S _____ T _____ R _____
- 3. Miscellaneous S _____ T _____ R _____
- Property in Sec. S _____ T _____ R _____

- 4. Lot No. _____, Recorded Plat _____
- 5. Private Claims _____

I, DONALD G. RICHARDS, in a field survey on December 3, 1993

do hereby certify that under requirements of P.A. 74, Michigan P.A. of 1970, the corner points mentioned in lines 1 and 2 above were in conformance with regulations and rules therefore as required in the current manual of survey instructions of the United States Department of the Interior, Bureau of Land Management or by a decree of a Court of Law and/or that the corner points mentioned in lines 3, 4 and 5 above were in conformance with the rules of the Michigan Board of Land Surveyors or by a Decree of a Court of Law; established, re-established, monumented, re-monumented, recovered, found as expressed below:

NOTE: Not more than 4 corners, all in the same town and range, may be recorded on this certificate.

A	B	C	D	E	F	G	H	I	J	K	L	M
2	6	5	4	3	2							
3		●										
4	7	8	9	10	11	12						
5												
6	13	14	15	16	17	18						
7												
8	19	20	21	22	23	24						
9												
10	25	26	27	28	29	30						
11												
12	31	32	33	34	35	36						
13												

A. Description of original monument and accessories and/or subsequent restoration:

Horatio Ball/Hervey C. Parke
Tuesday September 18th, 1821
W.O. 18 N 31 E .21
Sugar 11 S 22 W .23
(see reverse side for additional information)

B. Description of corner evidence found and/or method applied in restoring or reestablishing corner:

Found 3/4" pipe in Monument Box

SURVEY & REMONUMENTATION


MAR 16 1994

COMMISSION



C. Description of monument for corner and accessories established to perpetuate locating the position of the corner:

Set Bernsten monument SS-A5BR-30 stamped "Genesee County Remonumentation Corner" over 3/4" pipe in Monument Box
S 45 W 51.73' nail/GCWT* in NE face power pole
N 60 W 71.16' nail/GCWT in SE face power pole
N 50 E 57.30' nail/GCWT in SW face power pole
S 45 E 69.01' nail/GCWT in NW face power pole
WEST 2675.87' section corner C-3, T7N-R6E
EAST 2646.83' section corner E-3, T7N-R6E
(* Genesee County Witness Tag)

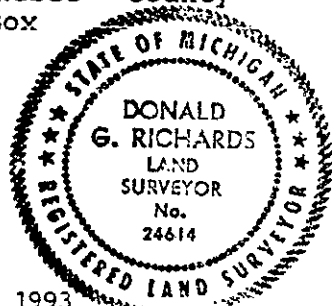

Signed by DONALD G. RICHARDS Date December 10, 1993

Surveyor's Michigan License No. 24614

APPROVED by Genesee County Monumentation Peer Group 12-01-93

GCRC TIES

No. 4: Iron pin in tile
NW 32.1 30" Maple
SW 43.6 RRS in maple
SSW 72.2 18" Walnut
SE 33.86 Anchor post in conc
SE 51.3 18" Maple

PA 74

pg 1 (1826/864) Ralph Landini 5-17-72
Found Iron pin
Util Pole N 55 W 72.07
Util Pole N 60 E 59.01
Util Pole S 40 E 67.69

pg 15 (1881/884-885) Karol R. Piotrowski 2-7-74
Found Pipe in Monumemnt Box
NE cor steel fence post S 45 W 65.35
Telephone pole S 50 E 67.70
Ex centerline Beecher Road North 3.00

PA 132 SURVEYS

2008/1-3
1820/165
1869/924 have Karol R. Piotrowski 7-10-73
same as PA 74 pg 15 above

Karol R. Piotrowski 9-29-75
Found Iron in Monument Box
N 55 W 72.07 Power Pole
N 60 E 59.01 Power Pole
S 40 E 67.69 Power pole

A.F. Miller 6-27-79 (rev 8-21-79)
Found Iron in Monument Box
PP N 55 W 72.07
PP N 60 E 59.01
PP S 40 E 67.69

A.F. Miller 10-16-79
Found Iron in Mon. Box