

REMONUMENTATION CORNER UNDER ACT 345, MICHIGAN PUBLIC ACTS OF 1990
LAND CORNER RECORDATION CERTIFICATE
 Filing Requirement of Act 74, Mich. P.A. 1970

For corners in

GENESEE

(County)

Located In:

Flint Twp


Corner Code #:

- | | | | | | |
|------------------------------------|---|-----------|---|-----------|------------|
| 1. Public Land Survey | T | <u>7N</u> | R | <u>6E</u> | <u>E-3</u> |
| | T | _____ | R | _____ | _____ |
| | T | _____ | R | _____ | _____ |
| | T | _____ | R | _____ | _____ |
| 2. Property Controlling in Section | S | _____ | T | _____ | _____ |
| | S | _____ | T | _____ | _____ |
| 3. Miscellaneous Property in Sec. | S | _____ | T | _____ | _____ |
| | S | _____ | T | _____ | _____ |

4. Lot No. _____, Recorded Plat _____
 5. Private Claims _____

RECORDED
 GENEESE COUNTY
 FLINT TWP MICHIGAN
 Dec 27 9 11 AM '93
 77968
 REGISTERED LAND SURVEYOR

FILED & RECORDED
 Register of Deeds Stamp & File Number

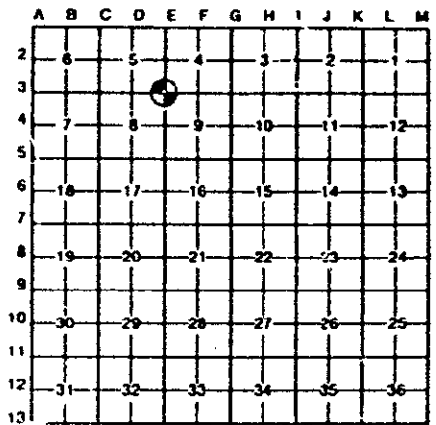

I, DONALD G. RICHARDS, in a field survey on December 3, 19 93, do hereby certify that under requirements of P.A. 74, Michigan P.A. of 1970, the corner points mentioned in lines 1 and 2 above were in conformance with regulations and rules therefore as required in the current manual of survey instructions of the United States Department of the Interior, Bureau of Land Management or by a decree of a Court of Law and/or that the corner points mentioned in lines 3, 4 and 5 above were in conformance with the rules of the Michigan Board of Land Surveyors or by a Decree of a Court of Law, established, re-established, monumented, re-monumented, recovered, found as expressed below:

NOTE: Not more than 4 corners, all in the same town and range, may be recorded on this certificate.

A. Description of original monument and accessories and/or subsequent restoration:

Horatio Ball/Hervey C. Parke
 Sunday September 16th or Monday the 17th, 1821
 Sugar 4 S 80 E 20
 Lynn 18 N 55 W 8
 (see reverse side for additional information)

B. Description of corner evidence found and/or method applied in restoring or reestablishing corner:

Found 1/2" pipe in Monument Box


SURVEY & REMONUMENTATION

MAR 16 1994



C. Description of monument for corner and accessories established to perpetuate locating the position of the corner:

Set Bernsten monument SS-A5BR-30 stamped "Genesee County Remonumentation Corner" over 1/2" pipe in Monument Box
 S 40 W 95.48' to center of operating nut of hydrant
 N 45 W 70.65' nail/GCWT* in SE face power pole
 N 45 E 71.12' nail/GCWT in SW face power pole
 S 45 E 69.75' nail/GCWT in NW face power pole
 WEST 2646.83' quarter corner D-3, T7N-R6E
 EAST 2645.57' quarter corner F-3, T7N-R6E
 (*Genesee County Witness Tag)

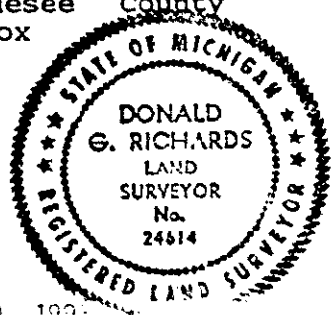

Signed by DONALD G. RICHARDS Date December 10, 1993

Surveyor's Michigan License No. 24614

APPROVED by Genesee County Monumentation Peer Group 12-01-93

GCRC TIES

No. 5: VOID

No. 55: Iron Rod
NW 35.8 Steel Anchor Post
WNW 59.40 10" Ash
SW 51.2 Road sign post
SE 51.2 Anchor post

PA 74

pg 1 (1826/864) Ralph Landini 5-17-72
Found Iron Rod
Fence Post N 25 W 37.46
Util Pole N 55 E 43.43
Sign Post S 50 E 69.27

pg 17 (1907/215-216) A. Vance Kupisch 2-5-75
Found rod in Monument Box
N 45 E 42.88 tag in power pole
S 50 E 69.22 face of county road sign
S 40 W 35.50 top center of manhole
N 25 W 37.41 steel corner fence post

PA 132 SURVEYS

Karol R. Piotrowski 9-29-75
Monument Box
N 25 W 37.46 Fence Post
N 55 E Power Pole
S 50 E 69.27 face of road sign

Donald G. Richards 1-20-93
Found 1/2" Pipe in Monument Box
S 45 E 70.29 nail/tag in Power Pole
S 45 W 70.41 base of road sign
N 45 W 71.33 nail/tag in power pole
N 40 E 71.54 nail/tag in power pole