

MAR 17 1999

1998 GENESEE COUNTY REMONUMENTATION PROGRAM
LAND CORNER RECORDATION CERTIFICATE
Filing Requirement of Act 74, Mich. P.A. 1970

SECTION LIBER 4013 PAGE 123

For corners in

Genesee County	Located In:	Corner Code #
1. Public Land Survey	T7N R7E	K-11
2. Property Controlling in Section	S ___ T ___ R ___	_____
3. Miscellaneous Property in Sec.	S ___ T ___ R ___	_____

106851

Register of Deeds Stamp & File Number

4. Lot No. _____, Recorded Plat _____
5. Private Claims _____

I, Kevin B. Cleaver, in a field survey on November 6, 1998, do hereby state that under requirements of P.A. 74, Michigan P.A. of 1970, the corner points mentioned in lines 1 and 2 above were in conformance with regulations and rules therefore as required in the current manual of survey instructions of the United States Department of the Interior, Bureau of Land Management or by a decree of a Court of Law and /or that the corner points mentioned in lines 3, 4 and 5 above were in conformance with the rules of the Michigan Board of Land Surveyors or by a Decree of a Court of Law; established, re-established, monumented, recovered, found as expressed below:

NOTE: Not more than 2 corners, all in the same town and range, may be recorded on this certificate.

	A	B	C	D	E	F	G	H	I	J	K	L	M
1													
2	6			5		4			3		2		1
3													
4	7			8		9			10		11		12
5													
6	18			17		16			15		14		13
7													
8	19			20		21			22		23		24
9													
10	30			29		28			27		26		25
11													
12	31			32		33			34		35		36
13													

A. Description of original monument and accessories and/or subsequent restoration:

7-21-1821 General Land Office (GLO) fieldnotes: set post w/two accessories
Undated Gould Engineering, Inc. (GEI) records: iron w/eight accessories
2-27-1979 Land Corner Recordation Certificate (LCRC), Liber 2034, Page 408: 3/4" pipe in monument box w/three accessories

B. Description of corner evidence found and/or method applied in restoring or reestablishing corner:

GLO corner and accessories not found
Corner and accessories from undated GEI records not found
Recovered 1" iron in monument box and all three accessories from 1979 LCRC

The monument found was ratified by the Genesee County Remonumentation Peer Review Committee on November 4, 1998

C. Description of monument for corner and accessories established to perpetuate locating the position of the corner:


Set in concrete the standard Bernsten monument SS-A-5BR-30 with 3 1/4" brass cap stamped "Genesee County Remonumentation Corner, 1998, #29242" over 1" iron in monument box.

N 33° E 58.32' set Genesee County Witness tag in northwest face power pole
S 35° E 81.05' found nail/tag #32332 in southwest face power pole
S 36° W 79.68' found nail/tag #32332 in east face power pole
N 45° W 70.61' found nail/tag #32332 in northeast face power pole

Ratified by Peer Group in accordance with P.A. 345, 1990

Co. Rep. Carl Carlson
Date 11-4-98

Signed by Kevin Banfield Cleaver
Kevin Banfield Cleaver, P.S.
Surveyor's Michigan License No. 29242

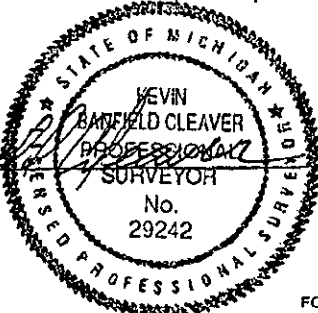

Date 12/8/98

GENESEE COUNTY REGISTER OF DEEDS
DEC 11 10 54 AM '98
Michael J. McCreary