

MAR 23 2000

1999 REMONUMENTATION PROGRAM
LAND CORNER RECORDATION CERTIFICATE
Filing Requirement of Act 74, Mich. P.A. 1970

Mal. J. Kenney

SECTION

Dec 28 10 37 AM '99

For corners in

Genesee County		Located In: Davison		Corner Code # B-5
1. Public Land Survey	T	7N	R 8E	B-5
	T		R	
	T		R	
	T		R	
2. Property Controlling In Section	S	T	R	
	S	T	R	
3. Miscellaneous Property in Section	S	T	R	
	S	T	R	
4. Lot No. _____	Recorded Plat _____			
5. Private Claim _____				

GENESEE COUNTY REGISTER OF DEEDS

Liber 4358, Pg. 733

Register of Deeds Stamp & File Num

I, David J. Kenney, in a field survey on November, 1999, do hereby state that under requirements of P.A. 74, Michigan P.A. of 1970, the corner points mentioned in lines 1 and 2 above were in conformance with regulations and rules therefore as required in the current manual of survey instructions of the United States Department of the Interior, Bureau of Land Management or by a decree of a Court of Law and/or that the corner points mentioned in lines 3, 4, and 5 above were in conformance with the rules of the Michigan Board of Land Surveyors or by a Decree of a Court of Law; established, re-established, monumented, re-monumented, recovered, found as expressed below:

A	B	C	D	E	F	G	H	I	J	K	L
1											
2	6		5		4		3		2		1
3											
4	7		8		9		10		11		12
5											
6	16		17		16		15		14		13
7											
8	19		20		21		22		23		24
9											
10	30		29		28		27		26		25
11											
12	31		32		33		34		35		36
13											

NOTE: Not more than 4 corners, all in the same town and range, may be recorded on this certificate

A. Description of original monument and accessories and/or subsequent restoration:

- 1822 G.L.O. Joseph Wampler D.S.
- 1979 L.C.R.C. L. 2033, P. 332 by Bernard Griggs, Jr. P.S. 14763
Found iron pin 0.3' below asphalt surface on centerline of Court St., 4 accessories
- 1987 Survey L. 2304, P. 118 by A. Vance Kupisch, L.S. #13586
Found 'T' iron in monument box, 3 accessories
- 1990 L.C.R.C. L. 2392, P. 158 by Grant T. Ward, P.S. #22445
Found 'T' iron in monument box, 4 accessories

B. Description of corner evidence found and/or method applied in restoring or reestablishing corner:

B-5 Section Corner, Section 7, 18, T7N-R8E, Davison Township

Found 'T' iron in monument box, and 1 accessory from 1979 (N05°W, 36.38', cap in utility pole), 1987 - 3 accessories, (South 51.98' tag E. face power pole, N05°W, 36.70' tag W. face power pole, N40°E, 32.83 'x' S. Rim Sanitary Manhole, 1990 - 4 accessories, (N75°E, 77.03' 60 d spkk/disc #22445, S. face 10" Elm, N70°W, 122.64' 60 d spk/disc #22445, S.W. face utility pole, S77°W, 92.82, 60 d spk/disc #22445, N.W. face 20" Ash, S08°W, 52.09', 60 d spk/disc #22445, E. face utility pole. Measured East 2650.71' also measured from B-5 to A-5. Measured 2668.59' (MDOT 2667.86'), Also angle from A-5, B-5, C-5, measured 179°38'03" (MDOT 179°38'46")

C. Description of monument for corner and accessories established to perpetuate locating the position of the corner:

B-5 Section Corner, Section 7, 18, T7N-R8E, Davison Township

N75°E, 77.03' Found Nail and Disc #22445, S. face 10" Elm
N70°W, 122.64' Found Nail and Disc #22445, S.W. face Utility Pole
S77°W, 92.82' Found Nail and Disc #22445, N.W. face 20" Ash
S08°W, 52.09' Found Nail and Disc #22556, E. face Utility Pole

Ratified by Genesee County Peer Group November 17, 1999. I the standard Bernstein monument (3 1/4" d. brass cap stam "Genesee County Remonumentation Corner, 1999" with 30" 3/8" O.D. stainless steel tube over 'T' iron.

Signed by


David J. Kenney

Date

December 27, 1999

Surveyor's Michigan License No.

39083

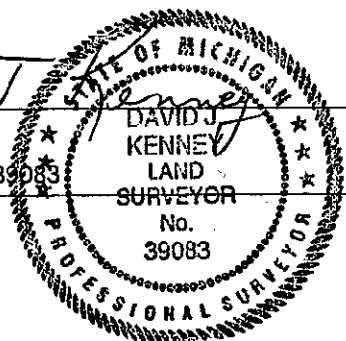

FORM APPROVED BY MICHIGAN STATE BOARD OF LAND SURVEYOR. JAN. 28, 19 REVISD MAY 14, 19 REVISD JAN., 19

Ratified by Peer Group in accordance with P.A. 345, 1990

Co. Rep. *Paul [Signature]*
Date 11-17-99