

SURVEY & REMONUMENTATION

MAR 23 2000

SECTION

**1999 REMONUMENTATION PROGRAM
LAND CORNER RECORDATION CERTIFICATE
Filing Requirement of Act 74, Mich. P.A. 1970**

Melvin S. Mc Lee

Dec 28 10 37 AM '99

For corners in

Genesee County		Located In: Davison		Corner Code # C-4
1. Public Land Survey		T 7N	R 8E	C-4
		T	R	
		T	R	
		T	R	
2. Property Controlling in Section	S	T	R	
	S	T	R	
3. Miscellaneous Property in Section	S	T	R	
	S	T	R	
4. Lot No.		Recorded Plat		
5. Private Claim				

GENESEE COUNTY REGISTER OF DEEDS

4358 P734

Register of Deeds Stamp & File Number

I, David J. Kenney, in a field survey on November, 1999, do hereby state that under requirements of P.A. 74, Michigan P.A. of 1970, the corner points mentioned in lines 1 and 2 above were in conformance with regulations and rules therefore as required in the current manual of survey instructions of the United States Department of the Interior, Bureau of Land Management or by a decree of a Court of Law and/or that the corner points mentioned in lines 3, 4, and 5 above were in conformance with the rules of the Michigan Board of Land Surveyors or by a Decree of a Court of Law; established, re-established, monumented, re-monumented, recovered, found as expressed below:

	A	B	C	D	E	F	G	H	I	J	K	L	M
1													
2		6		5		4		3		2		1	
3													
4		7	●	8		9		10		11		12	
5													
6		16		17		16		15		14		13	
7													
8		19		20		21		22		23		24	
9													
10		30		29		28		27		26		25	
11													
12		31		32		33		34		35		36	
13													

NOTE: Not more than 4 corners, all in the same town and range, may be recorded on this certificate

A. Description of original monument and accessories and/or subsequent restoration:

- 1822 G.L.O. Joseph Wampler D.S.
- 1928 G.C.R.C. Stake, 1 accessory
- 1976 Unrecorded survey - by Richard F. Franks, RLS #14093
Found solid iron bar 1.0' deep. Re-set 'T', 3 accessories
- 1978 G.C.R.C. Irish Road - Found 'T' in monument box, 3 accessories
- 1987 Survey L. 2304, P. 118 by A. Vance Kupisch, R.L.S. #13586
Found 'T' in monument box, 4 accessories
- 1990 L.C.R.C. L 2392, P. 159 by Grant J. Ward, P.S. #22445
Found 'T' iron in monument box, 4 accessories
- 1993 Survey L 3410, P. 635 by James E. Kauas, R.L.S. #33138
Found 'T' monument box, 4 accessories

Ratified by Peer Group in accordance with P.A. 345, 1990

Co. Rep. *Carl Carlson*
Date 11-17-99

B. Description of corner evidence found and/or method applied in restoring or reestablishing corner:

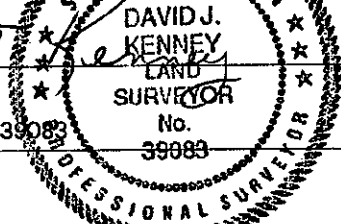
Found 'T' iron in monument box, and 1 accessory from 1928 G.C.R.C. Irish Road Plans. Distance from C-4 to C-5 by stationing of 2,633.4 feet. 1976 survey 2 accessories (West, 50.98 top center of right-of-way marker, easterly 35.35 top of hydrant). 1978 G.C.R.C. Irish Road plans, 3 accessories (NE 69.15 nail and cap in power pole, SE 93.03' nail and cap in power pole, SW, 44.20 nail and cap in power pole). 1987 survey found 'T' in monument box, 4 accessories (N45°E, 69.50 tag N. face power pole, S80°W, 44.88, tag N. face power pole, east, 35.20 hydrant, S85°E, 93.51 tag N. face power pole). 1990 L.C.R.C. and 1993 survey, some witnesses, 3 accessories (N50°E, 69.44' found nail/disc, NW face utility pole, S87°E, 93.48' found nail and disc, N. face utility pole, S78°W, 44.91 found nail and disc N. face utility pole).

During my field work I measured between C-4 and C-5, 2632.53', 1928 G.C.R.C. 2633.4, 1993 survey 2632.76.

C. Description of monument for corner and accessories established to perpetuate locating the position of the corner:

- N50°E, 69.11 Found Nail/disc Northwest Face Utility Pole
- S87°E, 93.03 Found Nail/disc North Face Utility Pole
- S78°W, 44.91 Found Nail/disc North Face Utility Pole
- East 35.35 Top of Fire Hydrant
- West 50.98 Top Center Right-of-Way Marker

Ratified by Genesee County Peer Group November 17, 1999. I set the standard Bernstein monument (3 1/4" d. brass cap stamped "Genesee County Remonumentation Corner, 1999" with 30" x 2 3/8" O.D. stainless steel tube over 'T' iron.

Signed by *David J. Kenney*

 Surveyor's Michigan License No. 39083

Date December 27, 1999