

REMONUMENTATION CORNER UNDER ACT 345, MICHIGAN PUBLIC ACTS OF 1970  
LAND CORNER RECORDATION CERTIFICATE  
Filing Requirement of Act 74, Mich. P.A. 1970

RECORDED  
RECORDED  
GENESEE COUNTY  
FLINT MICHIGAN  
DEC 27 9 11 AM '93  
77971  
RECORDED  
1100

Register of Deeds Stamp & File Number

For corners in GENESEE County

	Located in:	Corner Code
1. Public Land Survey	<u>Davison</u> 7N 8E	D-3
2. Property Controlling in Section	T ___ R ___ T ___ R ___ T ___ R ___ T ___ R ___	_____
3. Miscellaneous Property in Sec.	S ___ T ___ R ___ S ___ T ___ R ___ S ___ T ___ R ___	_____
4. Lot No. _____, Recorded Plat _____		
5. Private Claims _____		

	A	B	C	D	E	F	G	H	I	J	K	L	M
2													
3													
I, DONALD G. RICHARDS in a field survey on December 3, 19 93  
do hereby certify that under requirements of P.A. 74, Michigan P.A. of 1970, the corner points mentioned in lines 1 and 2 above were in conformance with regulations and rules therefore as required in the current manual of survey instructions of the United States Department of the Interior, Bureau of Land Management or by a decree of a Court of Law and/or that the corner points mentioned in lines 3, 4 and 5 above were in conformance with the rules of the Michigan Board of Land Surveyors or by a Decree of a Court of Law, established, re-established, monumented, re-monumented, recovered, found as expressed below.

NOTE: Not more than 4 corners, all in the same town and range, may be recorded on this certificate.


A. Description of original monument and accessories and/or subsequent restoration:  
Joseph Wampler and field party  
fall 1821  
NORTH 30 a Beech 18 in dmtr  
S 60 W 13 an Elm 22 in dmtr  
(see reverse side for additional information)

B. Description of corner evidence found and/or method applied in restoring or reestablishing corner:  
Found nail/flagging in Monument Box

SURVEY &  
REMONUMENTATION  
MAR 16 1994  
COMMISSION

C. Description of monument for corner and accessories established to perpetuate locating the position of the corner

Set Bernsten monument SS-A5BR-30 stamped "Genesee County Remonumentation Corner" over nail/flagging in Monument Box  
S 45 W 74.17' nail/GCWT\* in NE face power pole  
N 05 W 43.85' nail/GCWT in S face power pole  
N 60 E 98.64' nail/GCWT in SW face power pole  
S 50 E 75.38' nail/GCWT in NW face power pole  
WEST 2575.68' section corner C-3, T7N-R8E  
EAST 2430.89' section corner E-3, T7N-R8E  
(\* Genesee County Witness Tag)

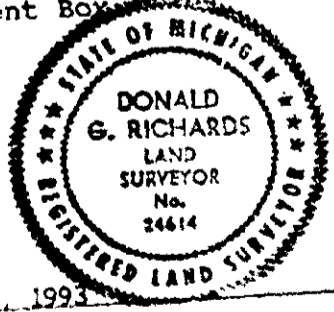

Signed by DONALD G. RICHARDS Date December 10, 1993

Surveyor's Michigan License No 24614  
APPROVED by Genesee County Monumentation Peer Group 12-01-93

PLATS

DEED  
LIBER 2520 PAGE 913

Richard H. Kraft July 17th, 1962  
BELLE MEADE, 37/40  
unidentified

GCRC TIES

No. '55: Iron pin & brick  
SW 26.0 2nd fence post west of fence intersection  
SOUTH 68.4 3rd fence post south of fence intersection  
NE 40.1 12" Maple  
NNE 83.2 18" Apple

PA 74

pg 22 (1907/211) A. Vance Kupisch 2-5-75  
Set nail with tag  
NORTH 43.90 tag in pole  
S 40 E 75.44 tag in pole  
S 30 W 74.52 tag in pole  
N 25 W 50.53 tag in 18" Maple

PA 132 SURVEYS

none