

MAR 23 2000

**1999 REMONUMENTATION PROGRAM
LAND CORNER RECORDATION CERTIFICATE
Filing Requirement of Act 74, Mich. P.A. 1970**

Melinda Kelly Mc Lee

DEC 28 10 37 AM '99

**GENESEE COUNTY
REGISTER OF DEEDS**

L 4358, P. 736

Register of Deeds Stamp & File Num


For corners in **SECTION**

Genesee County	Located In: Davison	Corner Code # D-5
1. Public Land Survey	T 7N R 8E	D-5
	T R	
	T R	
	T R	
2. Property Controlling in Section	S T R	
	S T R	
3. Miscellaneous Property in Section	S T R	
	S T R	
4. Lot No. _____	Recorded Plat _____	
5. Private Claim _____		

I, David J. Kenney, in a field survey on November, 1999, do hereby state that under requirements of P.A. 74, Michigan P.A. of 1970, the corner points mentioned in lines 1 and 2 above were in conformance with regulations and rules therefore as required in the current manual of survey instructions of the United States Department of the Interior, Bureau of Land Management or by a decree of a Court of Law and/or that the corner points mentioned in lines 3, 4, and 5 above were in conformance with the rules of the Michigan Board of Land Surveyors or by a Decree of a Court of Law; established, re-established, monumented, re-monumented, recovered, found as expressed below:

NOTE: Not more than 4 comers, all in the same town and range, may be recorded on this certificate

- A. Description of original monument and accessories and/or subsequent restoration:
- 1822 G.L.O. Joseph Wampler D.S.
 - 1956 Plat of "Norman Acres", L 30, P. 23 by Robert L. Mitchell, R.L.S. #6956
Monument not stated, no accessories
 - 1978 G.C.R.C. Court Street plans, found 'T' iron, set monument box, 3 accessories
 - 1984 Unrecorded survey by Richard F. Frank, R.L.S. #14093
 - 1988 Unrecorded survey by Richard H. Kraft, R.L.S. #10064
Monument not stated, no accessories
 - 1993 Survey L 3410, P. 639 by James E. Kauas, R.L.S. #33138, found monument, no accessories

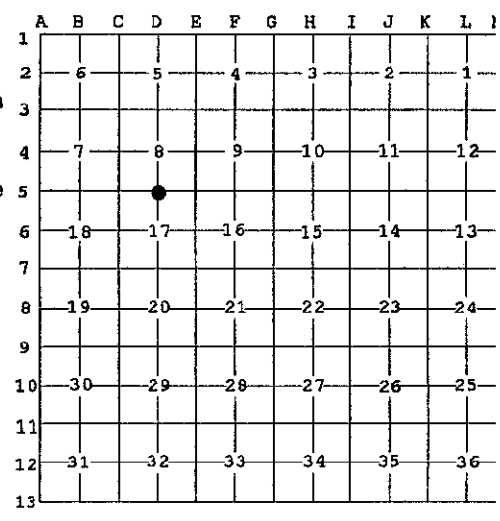

Ratified by Peer Group in accordance with P.A. 345, 199
Co. Rep. *Carl [Signature]*
Date 11-17-99

B. Description of corner evidence found and/or method applied in restoring or reestablishing corner:

D-5 Section Corner, Section 8, 17, T7N-R8E, Davison Township

Found 1/2" bent pipe in monument box in the centerline of Court Street and 1 accessory from Plat of "Norman Acres" 1956. Distance from D-5 to C-5 of 2497.66. 1978 G.C.R.C. 1 accessory (North 64.66 nail and tag in power pole) and distance by stationing from D-5 to C-5 of 2496.62' also from D-5 to E-5 of 2485.00'. The 1984 and 1988 unrecorded surveys show the distance from D-5 to C-5 of 2496.24' and from D-5 to E-5 of 2484.50 with angle from E-W by North of 179°50'32". 1993 survey shows the distance from D-5 to C-5 of 2496.79' and from D-5 to E-5 of 2484.74' with angle from E-W by North of 179°49'58".

During my field work I measured a distance of 2496.71' from D-5 to C-5 and from D-5 to E-5 of 2484.75 with angle from W-E by North of 179°49'58".

C. Description of monument for corner and accessories established to perpetuate locating the position of the corner:

D-5 Section Corner, Section 8, 17, T7N-R8E, Davison Township

North 64.75' Found Nail and Tag, East Face Power Pole
N15°W, 44.78 Chiseled '+' on South Rim Sanitary Manhole
S45°E, 48.13 Top of Metal Fence Post with Cable Marker Sign
South 15.00 Set 1/2 Re-rod in Shoulder of Court Street

Ratified by Genesee County Peer Group November 17, 1999. I set the standard Bernstein monument (3 1/4" d. brass cap stamped "Genesee County Remonumentation Corner, 1999" with 30" x 2 3/8" O.D. stainless steel tube over 1/2" bent pipe.

Signed by *David J. Kenney*
Surveyor's Michigan License No. **39083**

Date December 27, 1999