

SURVEY & REMONUMENTATION **1999 REMONUMENTATION PROGRAM**
LAND CORNER RECORDATION CERTIFICATE
Filing Requirement of Act 74, Mich. P.A. 1970

MAR 23 2000

For corners in

| | | | |
|--------------------------------------|----------------|---------------------|-------------------|
| Genesee County | SECTION | Located In: Davison | Corner Code # E-4 |
| 4 | | | |
| 1. Public Land Survey | T | 7N R 8E | E-4 |
| | T | R | |
| | T | R | |
| | T | R | |
| 2. Property Controlling in Section | S | T | R |
| | S | T | R |
| 3. Miscellaneous Property in Section | S | T | R |
| | S | T | R |
| 4. Lot No. | Recorded Plat | | |
| 5. Private Claim | | | |

Mel: Kelly McCue

DEC 28 10 38 AM '99

GENESEE COUNTY REGISTER OF DEEDS

L. 4358, P. 743

Register of Deeds Stamp & File Num

I, David J. Kenney, in a field survey on November, 1999, do hereby state that under requirements of P.A. 74, Michigan P.A. of 1970, the corner points mentioned in lines 1 and 2 above were in conformance with regulations and rules therefore as required in the current manual of survey instructions of the United States Department of the Interior, Bureau of Land Management or by a decree of a Court of Law and/or that the corner points mentioned in lines 3, 4, and 5 above were in conformance with the rules of the Michigan Board of Land Surveyors or by a Decree of a Court of Law; established, re-established, monumented, re-monumented, recovered, found as expressed below:

NOTE: Not more than 4 corners, all in the same town and range, may be recorded on this certificate

- A. Description of original monument and accessories and/or subsequent restoration:
- 1822 G.L.O. Joseph Wampler D.S.
 - 1973 L.C.R.C. L 1863, P. 102 by Karal R. Piotrowski, R.L.S. #9685
Found P.K. nail in conc. deck, 4 accessories
 - 1975 L.C.R.C. L 1906, P. 400 by Ronald W. Keller, R.L.S. #20707
Found P.K. nail, 4 accessories
 - 1978 G.C.R.C. Gale Road plans - Set P.K. nail, 2 accessories
 - 1985 L.C.R.C. L 2316, P. 263 by Joseph A. Wizynajtyts, Found P.K. nail, 4 accessories
 - 1985 Survey L 2330, P. 85 by Joseph A. Wizynajtyts, Found P.K. nail, 4 accessories
 - 1993 Survey L3410, P. 635 by James E. Kauas, R.L.S. #33138
Found P.K. nail, no accessories
 - 1997 Flint Surveying Section Corner Card, Found nail and tag, 4 accessories

B. Description of corner evidence found and/or method applied in restoring or reestablishing corner:

E-4 Section Corner, Section 8,9, T7N-R8E, Davison Township

Found P.K. nail in conc. bridge deck with 3 accessories from L.C.R.C. L 1863, P. 102 (N75°W, 48.90, power pole, chisled '+' in guard pole S60°E, 19.06', chisled '+' in guard pole S60°W 18.06'). 4 accessories from L.C.R.C. L 1906, P. 400 ('+' in top of concrete bridge pillar S45°E, 20.25'; '+' in top of concrete bridge pillar S45°W, 17.73'; '+' in top of concrete bridge pillar, N45°W, 15.70'; '+' in top of concrete bridge pillar N45°E, 17.80'), 1 accessory from G.C.R.C. Gale Road plans 1978, (N50°W, 48.47 power pole), 1985 survey L 2330, P. 85, 4 accessories (S45°E, 20.25', '+' in top of concrete bridge pillar, S45°W, 17.73'; '+' in top of concrete bridge pillar, N45°W, 15.70'; '+' in top of concrete bridge pillar, N45°E, 17.80'; '+' in top of concrete bridge pillar), L.C.R.C. L 2316, P. 263 in 1985 list the same 4 accessories as survey L 2330, P. 85; 1997 Flint Surveying Section Corner Card 3 accessories, S45°E, 84.07 Set nail and tag "KRC" in 14" Maple, N68°W, 47.30, set nail and tag "KRC" in power pole; N47°W, 60.60 set nail and tag "KRC" in power pole.

During my field work I measured from E-4 to E-5 a distance of 2640.65' which agree with the 1993 survey by Wade-Trim. The accessories are in agreement from 1973 to present.


C. Description of monument for corner and accessories established to perpetuate locating the position of the corner:

E-4 Section Corner, Section 8, 9, T7N-R8E, Davison Township

S45°E, 84.07 Found Nail and Tag "KRC" in West Face 14" Maple
 N68°W, 47.30 Found Nail and Tag "KRC" in Northeast Face of Power Pole
 N47°W, 60.60 Found Nail and Tag "KRC" in South Face of Power Pole
 S45°W, 17.78 Found '+' in Top of Conc. Bridge Pillar
 S45°E, 20.18 Found '+' in Top of Conc. Bridge Pillar

Ratified by Genesee County Peer Group November 17, 1999 set 3 1/4" d. brass cap stamped "Genesee Cour Remonumentation Corner, 1999" over P.K. nail.

Signed by *David J. Kenney* Date December 27, 1999

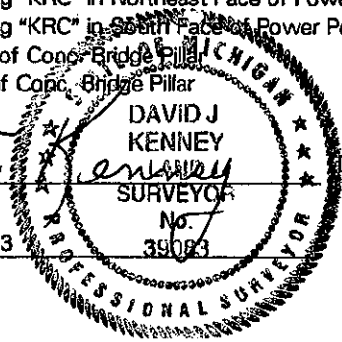

Surveyor's Michigan License No. 39083

