

REMONUMENTATION CORNER UNDER ACT 345, MICHIGAN PUBLIC ACTS OF 1970

LAND CORNER RECORDATION CERTIFICATE
Filing Requirement of Act 74, Mich. P.A. 1970

GENESEE COUNTY
FLINT MICHIGAN
NOV 27 9 11 AM '93
77973
FILED & RECORDED
Register of Deeds Stamp & File Number

For corners in
GENESEE

Located In: Danson Corner Code: F-3

- 1. Public Land Survey T 7N R 8E _____
T _____
T _____
T _____
- 2. Property Controlling S _____ T _____ R _____
in Section S _____ T _____ R _____
- 3. Miscellaneous S _____ T _____ R _____
Property in Sec. S _____ T _____ R _____

- 4. Lot No. _____, Recorded Plat _____
- 5. Private Claims _____

	A	B	C	D	E	F	G	H	I	J	K	L
2												
3												
I, DONALD G. RICHARDS, in a field survey on December 3, 1993
do hereby certify that under requirements of P.A. 74, Michigan P.A. of 1970, the corner points mentioned
in lines 1 and 2 above were in conformance with regulations and rules therefore as required in the
current manual of survey instructions of the United States Department of the Interior, Bureau of Land
Management or by a decree of a Court of Law and/or that the corner points mentioned in lines 3, 4 and 5
above were in conformance with the rules of the Michigan Board of Land Surveyors or by a Decree of a
Court of Law, established, re-established, monumented, re-monumented, recovered, found as
expressed below:

NOTE: Not more than 4 corners, all in the same town and range, may be recorded
on this certificate.

A. Description of original monument and accessories and/or subsequent restoration.

Joseph Wampler and field party
fall 1821
S 87 E 08 a Beech 11 in dmtr
N 18 W 06 a Beech 14 in dmtr
(see reverse side for additional information)

B. Description of corner evidence found and/or method applied in restoring or reestablishing corner.

Found iron in Monument Box


SURVEY &
REMONUMENTATION

MAR 16 1994

COMMISSIONER

C. Description of monument for corner and accessories established to perpetuate locating the position of the corner.

Set Bernsten monument SS-A5BR-30 stamped "Genesee County
Remonumentation Corner" over iron in Monument Box
S 50 W 78.16' nail/GCWT* in NE face power pole
N 50 W 66.74' nail/GCWT in E face 15" Ash
NORTH 45.01' nail/GCWT in S face power pole
SOUTH 37.90' nail/GCWT in N face power pole
WEST 2625.72' section corner E-3, T7N-R8E
EAST 2647.85' section corner G-1, T7N-R8E
(* Genesee County Witness Tag)

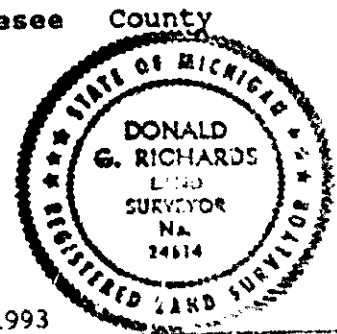

Signed by DONALD G. RICHARDS

Date December 10, 1993

Surveyor's Michigan License No 24614

APPROVED by Genesee County Monumentation Peer Group 12-01-93

PLATS

Gerald W. Smith, May 24th, 1946
ADAMS SUBDIVISION, 20/17
unidentified

GCRC TIES

No. 53: Iron "VOID see 144"
NW 37.9 15" Elm
SW 24.5 util pole
SOUTH 40.1 2nd fence post south of fence intersection

No. 144: Found "+" in pavement put PK nail/cap in asphalt (MSHD
1969) NORTH 60.00 plat monument
NNW 45.70 power pole
S 60 W 78.78 tele pole
S 15 E 30.90 13" Ash

PA 74

pg 9 (1875/588) Robert L. Mitchell 7-10-73
Found 1" pipe in Mon Box.
Power pole North 45.71
Power Pole South 38.10
Power Pole S 45 W 48.60

pg 20 (1906/400) have: Ronald W. Keller, ____ 1975
Found Monument Box
Plat monument North 60.0
P. Pole NW 45.70
13" Ash SE 30.60
T. Pole S 60 W 78.78

pg 55 (2382/449)
pg 64 (2469/781)

PA 132 SURVEYS

none

Robert L. Mitchell 7-10-73
same as PA 74 pg 9 above