

MAR 23 2000

1999 REMONUMENTATION PROGRAM
LAND CORNER RECORDATION CERTIFICATE
Filing Requirement of Act 74, Mich. P.A. 1970

Melinda McCee

Dec 28 10 38 AM '99

For corners in SECTION

Genesee County Located In: Davison Corner Code # F-5

1. Public Land Survey	T	7N	R 8E	F-5
	T		R	
	T		R	
	T		R	
2. Property Controlling in Section	S	T	R	
	S	T	R	
3. Miscellaneous Property in Section	S	T	R	
	S	T	R	

GENESEE COUNTY
REGISTER OF DEEDS

d 4258 P. 738

Register of Deeds Stamp & File Numt

4. Lot No. _____ Recorded Plat _____
5. Private Claim _____

A	B	C	D	E	F	G	H	I	J	K	L
1											
2	6		5		4		3		2		1
3											
4	7		8		9		10		11		12
5											
6	18		17		16		15		14		13
7											
8	19		20		21		22		23		24
9											
10	30		29		28		27		26		25
11											
12	31		32		33		34		35		36
13											

I, David J. Kenney, in a field survey on November, 1999, do hereby state that under requirements of P.A. 74, Michigan P.A. of 1970, the corner points mentioned in lines 1 and 2 above were in conformance with regulations and rules therefore as required in the current manual of survey instructions of the United States Department of the Interior, Bureau of Land Management or by a decree of a Court of Law and/or that the corner points mentioned in lines 3, 4, and 5 above were in conformance with the rules of the Michigan Board of Land Surveyors or by a Decree of a Court of Law; established, re-established, monumented, re-monumented, recovered, found as expressed below:

NOTE: Not more than 4 corners, all in the same town and range, may be recorded on this certificate

A. Description of original monument and accessories and/or subsequent restoration:

- 1971 Rowe Engineering Section Corner Card. Found 1/2" iron rod with Delta cap, 3 accessories
- 1974 Rowe Engineering Section Corner Card, Found 1/2" re-rod with Delta cap, 4 accessories
- 1975 L.C.R.C., L 1906, P. 400 by Ronald W. Keller, R.L.S. #20707, Found Delta Engineering rebar, 4 accessories
- 1978 Rowe Engineering Section Corner Card, Found Delta re-rod, 4 accessories
- 1997 Flint Surveying Section Corner Card, Found 1/2" re-rod, 4 accessories

B. Description of corner evidence found and/or method applied in restoring or reestablishing corner:

F-5 Section Corner, Section 9, 17, T7N-R8E, Davison Township

Found 1/2" re-rod in woods. Remains of old page wire fence to the North, East, and West, 2 accessories from Rowe Engineering Section Corner Card in 1971 (North 13.4', 14" Maple, S30°W, 64.5', 30" Maple). 2 accessories from Rowe Engineering Section Corner Card in 1974, (N10°E, 13.40', conc. nail and flagging in 14" Maple, N30°E, 37.70', conc. nail and flagging in 6" Maple). 2 accessories from 1975 LCRC, L1906, P. 400 (N10°E, 13.40', 14" Maple, N30°E, 37.70', 6" Maple). Rowe Engineering Section Corner Card in 1978 with 3 accessories (N10°E, 13.40, conc. nail and tag with flagging in 14" Maple, N30°E, 37.70, conc. nail and tag with flagging in 6" Maple, S30°W, 64.5, 30" Maple). 1997 Flint Surveying Section Corner Card with 4 accessories (N05°E, 13.78', found old spk in 19" Maple and N05°E, 13.78', set nail and tag "KRC" in 19" Maple, N30°E, 36.87', set nail and tag "KRC" in 7" Twin Maple, N75°E, 29.78', set nail and tag "KRC" in 11" Maple, West 11.07, set nail and tag in 50" Maple).

During my field work I measured a distance of 2629.55' from E-5 to F-5, (tax map shows 2630.75), also measured a distance of 2578.60' from F-5 to G-5 (tax map shows 2578.07').

C. Description of monument for corner and accessories established to perpetuate locating the position of the corner:

F-5 Section Corner, Section 9, 17, T7N-R8E, Davison Township


N05°E, 13.78', Found Nail and Tag "KRC" in 19" Maple
N30°E, 36.87', Found Nail and Tag "KRC" in 7" Twin Maple
N75°E, 29.78', Found Nail and Tag "KRC" in 11" Maple
West, 11.07', Found Nail and Tag "KRC" in 50" Maple

Ratified by Genesee County Peer Group November 17, 1999. I set 1 standard Bernstein monument (3 1/4" d. brass cap stamped "Genesee County Remonumentation Corner, 1999" with 30" x 2 3/8" O stainless steel tube over 1/2" re-rod.

Signed by *David J. Kenney*

Date December 27, 1999

Surveyor's Michigan License No. 39083

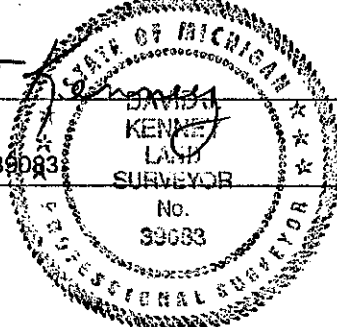

FORM APPROVED BY MICHIGAN STATE BOARD OF LAND SURVEYOR, JAN. 28, 1977
REVISED MAY 14, 1978
REVISED JAN., 1982

Ratified by Peer Group in accordance with P.A. 345, 1990

Co. Rep. *Carl Yankus*
Date 11-17-99