

REMONUMENTATION CORNER UNDER ACT 345, MICHIGAN PUBLIC ACTS OF 1990
LAND CORNER RECORDATION CERTIFICATE
 Filing Requirement of Act 74, Mich. P.A. 1970

For corners in

<u>GENESEE</u> (County)	Located In: <u>Danison</u>	Corner Code #1 <u>G-3</u>
1. Public Land Survey	T <u>7N</u> R <u>8E</u>	_____
	T _____ R _____	_____
	T _____ R _____	_____
	T _____ R _____	_____
2. Property Controlling in Section	S _____ T _____ R _____	_____
	S _____ T _____ R _____	_____
3. Miscellaneous Property in Sec.	S _____ T _____ R _____	_____
	S _____ T _____ R _____	_____
4. Lot No. _____, Recorded Plat _____		
5. Private Claims _____		

RECORDED
 REGISTERED
 DEC 27 9 11 AM '93
 GENESEE COUNTY
 FLINT MICHIGAN
 11/11

Register of Deeds Stamp & File Number

A	B	C	D	E	F	G	H	I	J	K	L	M
2	4	5	6	7	8	9	10	11	12	13	14	15
3												
4	7	8	9	10	11	12	13	14	15	16	17	18
5												
6	10	11	12	13	14	15	16	17	18	19	20	21
7												
8	13	14	15	16	17	18	19	20	21	22	23	24
9												
10	16	17	18	19	20	21	22	23	24	25	26	27
11												
12	19	20	21	22	23	24	25	26	27	28	29	30
13												

I, DONALD G. RICHARDS in a field survey on December 3, 19 93
 do hereby certify that the requirements of P.A. 74, Michigan P.A. of 1970, the corner points mentioned in lines 1 and 2 above were in conformance with regulations and rules therof as required in the current manual of instructions of the United States Department of the Interior, Bureau of Land Management or by a decree of a Court of Law and/or that the corner points mentioned in lines 3, 4 and 5 above were in conformance with the rules of the Michigan Board of Land Surveyors or by a Decree of a Court of Law; established, re-established, monumented, re-monumented, recovered, found as expressed below:

NOTE: Not more than 4 corners, all in the same town and range, may be recorded on this certificate.

A. Description of original monument and accessories and/or subsequent restoration:

Joseph Wampler and field party
 fall 1821
 S 50 E 15 a Beech 14 in dmtr
 N 20 E 11 a Beech 6 in dmtr
 (see reverse side for additional information)

B. Description of corner evidence found and/or method applied in restoring or reestablishing corner

Found rerod/cap in Monument Box


SURVEY &
 REMONUMENTATION

MAR 16 1994

COMMISSION

C. Description of monument for corner and accessories established to perpetuate locating the position of the corner:

Set Bernsten monument SS-A5BR-30 stamped "Genesee County Remonumentation Corner" over rerod/cap in Monument Box
 S 45 W 114.96' NE corner of steel support post of gaspump
 N 60 W 60.65' nail/GCWT* in E face power pole
 N 40 E 59.95' nail/GCWT in SW face power pole
 S 50 E 56.48' center of NW anchor bolt of light pole
 WEST 2647.95' quarter corner F-3, T7N-R8E
 EAST 2638.72' quarter corner K-3, T7N-R8E
 (* Genesee County Witness Tag)

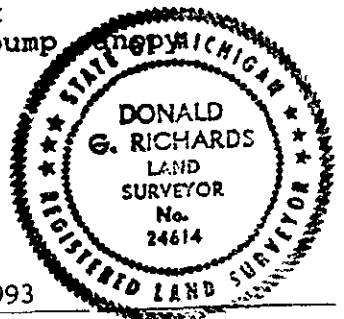

Signed by DONALD G. RICHARDS Date December 10, 1993

Surveyor's Michigan License No. 24614

APPROVED by Genesee County Monumentation Peer Group 12-01-93

Seth N. Beden May 16-18th, 1882
Stone

PLATS

S.R. Billings, May 11th, 1871
MAP OF THE VILLAGE OF DAVISON, 14/42
unidentified

S.R. Billings, May 3rd, 1884
RISING'S ADDITION, 1/22
unidentified

S. R. Billings, August 1st, 1890
E.W. RISING'S 2ND ADDITION, 1/27
unidentified

Moses Middleton, August 24th, 1893
HILLS ADDITION TO THE VILLAGE OF DAVISON, 1/35
unidentified

Robert B. McFarlan, June 11th, 1927
ASSESSOR'S PLAT, 13/57-58
unidentified

Robert B. McFarlan, June 4th, 1928
ASSESSOR'S PLAT NO. 1, 15/49
unidentified

GCRC TIES

No. 3: Stone
NW 83.5 SE cor of(symbol?) at Gas Sta
WNW 81.68 SE cor of(symbol?) at Gas Sta
WSW 34.0 3" Maple
SE 60.7 (symbol?)
ENE 78.9 (symbol?)
NE 78.9 (symbol?)
NNE 47.1 (symbol?)

PA 74

pg 46 (2320/532) Jack N. Owens 3-17-88
Set PK Nail
N 40 E 71.79 SE corner 9" square steel sign post in concrete
S 55 E 58.69 NE bolt (1" dia.) steel base of street and traffic
light pole on concrete pedestal
S 47 W 96.40 NE corner of concrete pavement for covered pump
islands
N 22 W 121.25 SW bolt of W'ly of two 9" square steel support posts
of sign in concrete

pg 56 (2382/450) Norman C. Caldwell 9-13-89
Found empty monument box; set 1/2 bar w/LS 20709 cap
N 40 E 71.79 SE corner of square steel sign post
S 55 E 58.69 NE bolt steel base of Light Pole
S 47 W 96.40 NE corner of concrete pavement for pump islands
N 22 W 121.25 SW bolt of W'ly square steel sign post base

pg 64 (2469/781) Victor J. Lukasavitz 8-12-92
Found Rowe Engineering rod in Monument Box
N 40 W 61.28 nail/tag in NE face Power Pole
N 45 E 60.40 nail/tag in NW face Power Pole
S 30 E 102.11 NW face power pole

PA 132 SURVEYS

2482/503-506
Paul N. Brown 11-9-92
Held center mon box
S 46-37 W 97.64 NE cor conc pavt for pump islands (covered)
N 23-53 W 122.07 SW bolt W'ly 9" sq street sign post in conc
N 37-51 E 70.84 SE cor 9" sq steel sign post in conc
S 54-30 E 56.57 Ne bolt (1"dia) steel base st & traffic lt pole