SURVEY &
REMONUMENTATION

MAR 23 2000

1999 REMONUMENTATION PROGRAM
LAND CORNER RECORDATION CERTIFICATE
Filing Requirement of Act 74, Mich. P.A. 1970

Michelle Kelly McCree

For corners in SECTION

Genesee County | Located In: Davison | Corner Code # G-5

DEC 28 10 38 AM '99

GENESEE COUNTY
REGISTER OF DEEDS

L. 4358, P. 740

Register of Deeds Stamp & File Numb

1.	Public Land Survey		T 7N	R 8E	G-5
			T	R	
			T	R	
			T	R	
2.	Property Controlling	S	T	R	
	in Section	S	T	R	
3.	Miscellaneous	S	T	R	
	Property in Section	S	T	R	

4. Lot No. _____ Recorded Plat _____
5. Private Claim _____

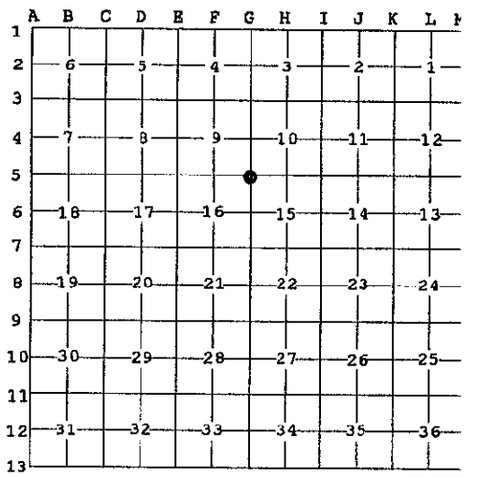

I, David J. Kenney, in a field survey on November, 1999, do hereby state that under requirements of P.A. 74, Michigan P.A. of 1970, the corner points mentioned in lines 1 and 2 above were in conformance with regulations and rules therefore as required in the current manual of survey instructions of the United States Department of the Interior, Bureau of Land Management or by a decree of a Court of Law and/or that the corner points mentioned in lines 3, 4, and 5 above were in conformance with the rules of the Michigan Board of Land Surveyors or by a Decree of a Court of Law; established, re-established, monumented, re-monumented, recovered, found as expressed below:

NOTE: Not more than 4 corners, all in the same town and range, may be recorded on this certificate

A. Description of original monument and accessories and/or subsequent restoration:

1822 G.L.O. Joseph Wampler D.S.
1929 M-15 Highway plans, Found 3/4" pipe, 4 accessories
1971 Rowe Engineering Section Corner Card, Found iron in monument box, 3 accessories
1972 L.C.R.C., L 1881, P. 878 by Karol R. Piotrowski, Found 3/4" bar in monument box, 3 accessories
1975 L.C.R.C., L 1906, P. 400 by Ronald W. Keller, Found monument box, 3 accessories
1977 Rowe Engineering Section Corner Card, Found 7/8" rod in monument box, 3 accessories
1987 L.C.R.C., L 2326, P. 593, Found iron in monument box, set 'T' above iron, 3 accessories
1989 Rowe Engineering Section Corner Card, Found 'T' in monument box, 4 accessories
1991 Rowe Engineering Section Corner Card, Found Gould 'T' in monument box, 7 accessories
1997 Flint Engineering Section Corner Card, Found 'T' iron and cap #13586 in monument box, 4 accessories

B. Description of corner evidence found and/or method applied in restoring or reestablishing corner:

G-5 Section Corner, Section 9, 10, 15, 16, T7N-R8E, Davison Township

Found 'T' iron with cap #13586 in monument box at the east edge of the center lane of M-15, and 2 accessories from L.C.R.C., L1881, P. 878 (power pole N88°W, 52.26', and power pole, S40°E, 78.20'). L.C.R.C., L 1906, P. 400, 1 accessory (telephone pole, West, 52.30'), Rowe Engineering Section Corner Card, 1977, 1 accessory (West, 52.25, P.K. and disc in telephone pole). L.C.R.C., L 2326, P. 593, 3 accessories (West 51.55 N & T in N. face power pole, N80°E, 45.57, MDSH tag N. face power pole, S45°E, 78.69 MDSH tag NE face power pole), Rowe Engineering Section Corner Card, 1989, 3 accessories (West, 51.50 N & T, NE face power pole, N85°E, 45.62 nail/MSHO tag N face power pole, S35°E, 78.25, P.K. and disc, NW face power pole). Rowe Engineering Section Corner Card, 1991, 3 accessories, (West, 51.50 found 40 d nail NE face power pole, S34°E, 78.27, found P.K. with cap, NW face power pole, N82°E, 45.66, found nail with MDSH tag N face of telephone pole. Flint Surveying Section Corner Card, 1997, 4 accessories (West, 51.57 found nail and tag "Bonno" in power pole, S34°E, 78.42, found nail and tag in power pole, N83°E, 45.64, found nail and tag "MSHO" in power pole, N21°E, 122.93', found nail and tag in "Bonno" in power pole.

During my field work I measured a distance of 2578.60' from G-5 to F-5, (tax map shows 2578.07'), also measured along M-15 from G-5 to G-4 a distance of 2751.10'.

C. Description of monument for corner and accessories established to perpetuate locating the position of the corner:

G-5 Section Corner, Section 9, 10, 15, 16, T7N-R8E, Davison Township

West 51.57', Found Nail and Tag "Bonno" in Power Pole
S34°E, 78.84', Found Nail and Tag "Bonno" in Power Pole
N83°E, 45.60', Found Nail and Tag "Bonno" in Power Pole
N21°E, 122.93, Found Nail and Tag "Bonno" in Power Pole

Ratified by Genesee County Peer Group November 17, 1999. I set tl standard Bernstein monument (3 1/4" d. brass cap stamped "Genes County Remonumentation Corner, 1999" with 30" x 2 3/8" O. stainless steel tube over 'T' iron with cap.

Signed by David J. Kenney

STATE OF MICHIGAN
DAVID J. KENNEY
LAND SURVEYOR
No. 39083
PROFESSIONAL SURVEYOR

Date December 27, 1999

Surveyor's Michigan License No. 39083

FORM APPROVED BY MICHIGAN STATE BOARD OF LAND SURVEYORS, MAY 1971
REVISED MAY 14, 1975
REVISED JAN. 1980

Ratified by Peer Group I
accordance with P.A. 345, 199
Co. Rep. Carl Conkin
Date 11-17-99