

SURVEY & REMONUMENTATION

**1999 REMONUMENTATION PROGRAM
LAND CORNER RECORDATION CERTIFICATE
Filing Requirement of Act 74, Mich. P.A. 1970**

MAR 23 2000

Melvin P. McCree

DEC 28 10 38 AM '99

For corners in

SECTION

Genesee County

Located In: Davison

Corner Code # H-5

- | | | | | | |
|--------------------------------------|---------------|----|---|----|-----|
| 1. Public Land Survey | T | 7N | R | 8E | H-5 |
| | T | | R | | |
| | T | | R | | |
| | T | | R | | |
| 2. Property Controlling in Section | S | T | R | | |
| | S | T | R | | |
| 3. Miscellaneous Property in Section | S | T | R | | |
| | S | T | R | | |
| 4. Lot No. | Recorded Plat | | | | |
| 5. Private Claim | | | | | |

GENESEE COUNTY REGISTER OF DEEDS

24358, P. 741

Register of Deeds Stamp & File Num

I, David J. Kenney, in a field survey on November, 1999, do hereby state that under requirements of P.A. 74, Michigan P.A. of 1970, the corner points mentioned in lines 1 and 2 above were in conformance with regulations and rules therefore as required in the current manual of survey instructions of the United States Department of the Interior, Bureau of Land Management or by a decree of a Court of Law and/or that the corner points mentioned in lines 3, 4, and 5 above were in conformance with the rules of the Michigan Board of Land Surveyors or by a Decree of a Court of Law; established, re-established, monumented, re-monumented, recovered, found as expressed below:

NOTE: Not more than 4 corners, all in the same town and range, may be recorded on this certificate

A. Description of original monument and accessories and/or subsequent restoration:

- 1822 G.L.O. Joseph Wampler D.S., Set post
- 1932 Supervisor's Plat #10 L 17, P. 15 - Found 18" fence post, no accessories
- 1980 Manford Heights No. 5, L 59, P. 17 - Set concrete monument
- 1996 Unrecorded Survey by Rowe Engineering, #F-10744-96-S - Found 'T' iron, 5 accessories
- 1999 Flint Surveying Section Corner Witnesses Card, Found concrete monument, 4 accessories

B. Description of corner evidence found and/or method applied in restoring or reestablishing corner:

H-5 Section Corner, Section 10, 15, T7N-R8E, Davison Township

Found 'T' iron and concrete monument. 'T' iron has 5 accessories from unrecorded survey by Rowe Engineering in 1996 (East 0.54' Found concrete monument, North 23.35' Set nail and flag in E face 8" Locust, S05°W, 4.04' Found nail in E face 15" Box Elder, N85°W, 84.46', SE corner house #745 Locust Drive, S35°E, 52.94', Set nail and flag in NE face light pole. The concrete monument has 3 accessories from Flint Surveying Section Corner Card, (N05°E, 25.32' Set mag and FSE tag in E face 10" Silver Maple, S30°E, 52.38' Set mag and FSE tag in NE face power pole S30°W, 4.40' Set mag and FSE tag in E face 12" Twin Elm.

During my field work I measured a distance of 2626.27' from G-5 to H-5. The plat for Supervisor's Plat #10 calls for 2626.0' from G-5 to H-5. For Manford Heights No. 5, I measured from the SW corner to the 'T' iron a distance of 369.25' (plat 369.15'), also measured from the 'T' iron at H-5 to the NE corner of Manford Heights No. 5 a distance of 1061.16' (plat 1061.30').

The 'T' iron best fits the position for H-5, based on the plat of Supervisor's Plat #10 and Manford Heights No. 5.

C. Description of monument for corner and accessories established to perpetuate locating the position of the corner:


H-5 Section Corner, Section 10, 15, T7N-R8E, Davison Township
 N05°E 25.40' Found mag and FSE tag in E face 10" Silver Maple
 S30°E 52.44' Found mag and FSE tag in NE face power pole
 S30°W 4.08' Found mag and FSE tag in E face 12" Twin Elm
 East 0.54' Found concrete monument

Ratified by Genesee County Peer Group November 24, 1999. I set the standard Bernstein monument (3 1/4" d. brass cap stamped "Genesee County Remonumentation Corner, 1999" with 30" x 2 3/8" O.D. stainless steel tube over 'T' iron.

Signed by David J. Kenney

Date December 27, 1999

Surveyor's Michigan License No. 39083

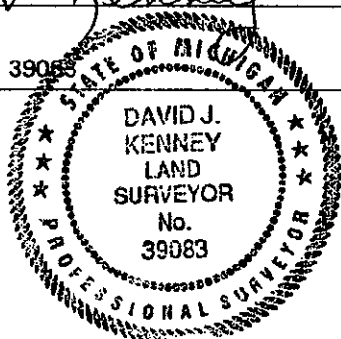

FORM APPROVED BY MICHIGAN STATE BOARD OF LAND SURVEYOR, JAN. 28, 1971
 REVISED MAY 14, 1975
 REVISED JAN., 1983

Ratified by Peer Group in accordance with P.A. 345, 1990

Co. Rep. Carl Carlson
 Date 11-24-99

