

SURVEY & REMONUMENTATION 1999 REMONUMENTATION PROGRAM
LAND CORNER RECORDATION CERTIFICATE
 Filing Requirement of Act 74, Mich. P.A. 1970

MAR 23 2000

Melvin S. McCree

For corners in

SECTION

Genesee County	Located In: Davison	Corner Code # I-4
1. Public Land Survey	T 7N R 8E I-4	
	T R	
	T R	
	T R	
2. Property Controlling in Section	S T R	
	S T R	
3. Miscellaneous Property in Section	S T R	
	S T R	
4. Lot No. _____	Recorded Plat _____	
5. Private Claim _____		

Dec 28 10 38 AM '99

GENESEE COUNTY REGISTER OF DEEDS

L. 4358, P. 742

Register of Deeds Stamp & File Num

I, David J. Kenney, in a field survey on November, 1999, do hereby state that under requirements of P.A. 74, Michigan P.A. of 1970, the corner points mentioned in lines 1 and 2 above were in conformance with regulations and rules therefore as required in the current manual of survey instructions of the United States Department of the Interior, Bureau of Land Management or by a decree of a Court of Law and/or that the corner points mentioned in lines 3, 4, and 5 above were in conformance with the rules of the Michigan Board of Land Surveyors or by a Decree of a Court of Law; established, re-established, monumented, re-monumented, recovered, found as expressed below:

NOTE: Not more than 4 corners, all in the same town and range, may be recorded on this certificate

A	B	C	D	E	F	G	H	I	J	K	L
1											
2	6	5	4	3	2	1					
3											
4	7	8	9	10	11	12					
5											
6	18	17	16	15	14	13					
7											
8	19	20	21	22	23	24					
9											
10	30	29	28	27	26	25					
11											
12	31	32	33	34	35	36					
13											

A. Description of original monument and accessories and/or subsequent restoration:

- 1822 G.L.O. Joseph Wampler D.S. - Set post
GCRC, P. 7 Witness book - Found iron, 3 accessories
- 1973 LCRC, L 1863, P. 101 by Karol Piotrowski - Found 1/2" re-rod, 2 accessories
- 1976 GCRC, Oak Road plans - Found 1/2" re-rod, set monument box, 2 accessories

B. Description of corner evidence found and/or method applied in restoring or reestablishing corner:

I-4 Section Corner, Sections 10,11, T7N-R8E, Davison Township.

Found monument box, set re-rod with Kraft cap from record witnesses. 1 accessory from 1973 LCRC, L 1863, P. 101 (power pole, N35°E, 105.57'). Copy of field notes provided by B.F. Thompson with 4 accessories (East 39.38, found nail with Delta cap, south side wood fence post, S30°E 71.97 found P.K. nail SW side wood fence post, S85°W, 50.19' found 'T' iron with cap, N30°E, 105.59 found P.K. nail, SE side power pole).

During my field work I measured a distance of 2846.27' from I-4 to I-5 (GCRC by stations 2847.35', LCRC L 1863, P. 101 2849.35'), and from I-4 to I-3 a distance of 2615.89 (LCRC L 1863, P. 101, 2616.35'). The measured field angle at I-4 from I-3 to I-5 by east was 178°24'35" (GCRC shows 178°30'15") and B.F. Thompson shows 178°24'40").


C. Description of monument for corner and accessories established to perpetuate locating the position of the corner:

I-4 Section Corner, Sections 10,11, T7N-R8E, Davison Township.

- S85°W 50.19' Found 'T' iron with cap
- N30°E 105.60' Found P.K. nail, SE side power pole
- N40°E 78.43' Found chisled '+' on top, east end 48" CMP
- N40°W 77.11' Found chisled '+' on top, west end 48" CMP

Ratified by Genesee County Peer Group November 24, 1999. I set the standard Bernstein monument (3 1/4" d. brass cap stamped "Genesee County Remonumentation Corner, 1999" with 30" x 2 3/8" O.D. stainless steel tube over monument box.

Signed by *David J. Kenney*
 Surveyor's Michigan License No. 39083

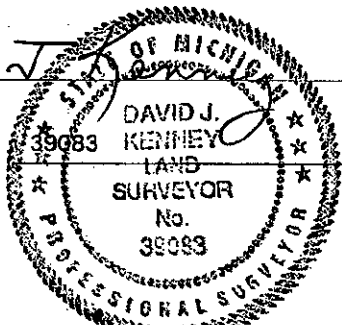

Date December 27, 1999

FORM APPROVED BY MICHIGAN STATE BOARD OF LAND SURVEYOR, JAN. 28, 1971
 REVISED MAY 14, 1976
 REVISED JAN., 1983

Ratified by Peer Group in accordance with P.A. 345, 1990

Co. Rep. *Carl Carlson*
 Date 11-24-99