

**SURVEY & REMONUMENTATION 1999 REMONUMENTATION PROGRAM
LAND CORNER RECORDATION CERTIFICATE**
Filing Requirement of Act 74, Mich. P.A. 1970

MAR 23 2000

Mark Phillip McCree

For corners in

Genesee County	SECTION	Located In: Davison	Corner Code # K-4
1. Public Land Survey	T	7N R 8E	K-4
	T	R	
	T	R	
	T	R	
2. Property Controlling in Section	S	T	R
	S	T	R
3. Miscellaneous Property in Section	S	T	R
	S	T	R
4. Lot No. _____	Recorded Plat _____		
5. Private Claim _____			

DEC 28 10 39 AM '99

GENESEE COUNTY REGISTER OF DEEDS

4358, P. 745

Register of Deeds Stamp & File Numt

I, David J. Kenney, in a field survey on November, 1999, do hereby state that under requirements of P.A. 74, Michigan P.A. of 1970, the corner points mentioned in lines 1 and 2 above were in conformance with regulations and rules therefore as required in the current manual of survey instructions of the United States Department of the Interior, Bureau of Land Management or by a decree of a Court of Law and/or that the corner points mentioned in lines 3, 4, and 5 above were in conformance with the rules of the Michigan Board of Land Surveyors or by a Decree of a Court of Law; established, re-established, monumented, re-monumented, recovered, found as expressed below:

A	B	C	D	E	F	G	H	I	J	K	L
1											
2	6	5	4	3	2	1					
3											
4	7	8	9	10	11	12					
5											
6	18	17	16	15	14	13					
7											
8	19	20	21	22	23	24					
9											
10	30	29	28	27	26	25					
11											
12	31	32	33	34	35	36					
13											

NOTE: Not more than 4 corners, all in the same town and range, may be recorded on this certificate

A. Description of original monument and accessories and/or subsequent restoration:

- 1822 G.L.O. Joseph Wampler D.S. - Set post
- 1974 Consumers Power Company Survey, L 2481, P. 629 & 630 by Glenn A. Fauser, RLS #18557 - Found fence corner, fence each direction, 3 accessories

B. Description of corner evidence found and/or method applied in restoring or reestablishing corner:

K-4 Section Corner, Section 11, 12, T7N-R8E, Davison Township

Found fence corner post with 1 accessory from 1974 survey (12" Twin Oak, NNE 16.75').

In the field I found the wood fence corner post with fence in 3 directions as called for in the 1974 survey. The fence post is broken at the bottom. I retracted the 1974 Consumers Power Company survey by Glenn A. Fauser for Section 11. I recovered a 1/2" re-rod 1502.74 feet east of the interior 1/4 corner, shown on survey as 1502.63 feet, then extended the line to the east a record distance of 2605.12 feet for the position of K-4. From K-4 to K3 the measured distance of 2724.75 feet matches the 1974 survey. The angle from J-4 to K-3 at K-4 is 88°37'23" (recorded as 88°35'52"). From K-4 to K-5, I measured 2635.38 feet (recorded as 2633.18 feet). The difference is due to Glenn Fauser calling for a wood fence post at K-5, instead of a 3/4" iron rod 2.0' +/- south of the fence post. Along the line K-5 to K-4, I found a very old 'T' iron, 0.5 feet west of fence intersection, a distance of 1316.43 feet north of K-5 and 0.18 feet west of line. I set an iron re-rod with Kraft cap in the base of the old fence post.

K-4 Section Corner, Section 11, 12, T7N-R8E, Davison Township

- N10°E 16.75' Set GC Nail & Tag, West face of 24" Twin Oak
- S30°E 14.29' Set GC Nail & Tag, Northeast face of 8" Oak
- S10°E 15.43' Set GC Nail & Tag, East face 12" Oak
- N65°W 8.38' Set GC Nail & Tag, Northeast face 10" Oak
- East 33' +/- center of north-south farm lane
- S0°27'44"E, 2635.20' K-5, Southeast corner Section 11
- N89°24'56"W, 2605.12' J-4, Interior 1/4 corner Section 11

Ratified by Genesee County Peer Group December 8, 1999. I set the standard Bernstein monument (3 1/4" d. brass cap stamped "Genesee County Remonumentation Corner, 1999" with 30" x 2 3/8" O.D. stainless steel tube over wood fence corner post.


Signed by

David J. Kenney

Date December 27, 1999

Surveyor's Michigan License No.

39083

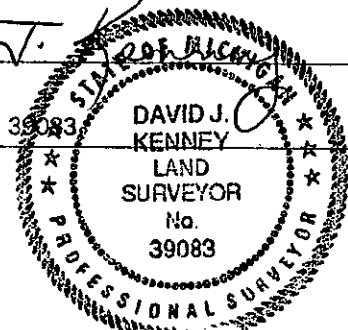

FORM APPROVED BY MICHIGAN STATE BOARD OF LAND SURVEYOR, JAN. 28, 1971
REVISED MAY 14, 1976
REVISED JAN., 1983

Ratified by Peer Group in accordance with P.A. 345, 1990

Co. Rep. *Carl [Signature]*

Date 12-8-99