

**SURVEY & REMONUMENTATION**

MAR 23 2000

**1999 REMONUMENTATION PROGRAM  
LAND CORNER RECORDATION CERTIFICATE  
Filing Requirement of Act 74, Mich. P.A. 1970**

*John J. McCee*

For corners in

**SECTION**

DEC 28 10 39 AM '99

**GENESEE COUNTY  
REGISTER OF DEEDS**

*2. 4358, P. 746*

Register of Deeds Stamp & File Num

Genesee County	Located In: Davison	Corner Code # K-5
1. Public Land Survey	T 7N R 8E	K-5
	T _____ R _____	_____
	T _____ R _____	_____
	T _____ R _____	_____
2. Property Controlling in Section	S _____ T _____ R _____	_____
	S _____ T _____ R _____	_____
3. Miscellaneous Property in Section	S _____ T _____ R _____	_____
	S _____ T _____ R _____	_____

4. Lot No. \_\_\_\_\_ Recorded Plat \_\_\_\_\_  
5. Private Claim \_\_\_\_\_

I, David J. Kenney, in a field survey on November, 1999, do hereby state that under requirements of P.A. 74, Michigan P.A. of 1970, the corner points mentioned in lines 1 and 2 above were in conformance with regulations and rules therefore as required in the current manual of survey instructions of the United States Department of the Interior, Bureau of Land Management or by a decree of a Court of Law and/or that the corner points mentioned in lines 3, 4, and 5 above were in conformance with the rules of the Michigan Board of Land Surveyors or by a Decree of a Court of Law; established, re-established, monumented, re-monumented, recovered, found as expressed below:

**NOTE: Not more than 4 corners, all in the same town and range, may be recorded on this certificate**

A. Description of original monument and accessories and/or subsequent restoration:

- 1822 G.L.O. Joseph Wampler D.S. - Set post
- 1967 Unrecorded Survey, West Engineering - Found 1" pipe, 4 accessories
- 1974 Consumers Power survey, L 2481, P. 629 & 630 - Found fence corner post, no accessories
- 1977 LCRC, L 2021, P. 682 by Kenneth D. Dunton RLS #23503 - Found 1" pipe, raised with 3/4" iron rod, 4 accessories

A	B	C	D	E	F	G	H	I	J	K	L
1											
2	6		5		4		3		2		1
3											
4	7		8		9		10		11		12
5											
6	16		17		16		15		14		13
7											
8	19		20		21		22		23		24
9											
10	30		29		28		27		26		25
11											
12	31		32		33		34		35		36
13											

B. Description of corner evidence found and/or method applied in restoring or reestablishing corner:

K-5 Section Corner, Section 11, 12, 13, 14, T7N-R8E, Davison Township

Found 3/4" iron rod. 3 accessories from 1967 unrecorded survey by West Engineering (East 21.90', 9" Hickory, N5°W, 28.52', 7" Hickory, South 113.75' centerline Lapeer Road 113.75'). 3 accessories from 1977 LCRC (North 2.40' Fence Post, East 22.10, 10" Shagbark Hickory, West 16.34 RLS 11192 tag in 6" Shagbark Hickory).

In the field I found 3/4" iron rod as set in 1977 by LCRC, L. 2021, P. 682. The witnesses from 1967 unrecorded survey and the 1977 LCRC are mostly still intact. The fence corner post as called for in 1974 survey is very deteriorated and broken off at the bottom. I measured from K5 to J5 a distance of 2577.95', Consumers survey shows 2577.26'. Also from K-5 to K-4 I measured 2635.20' and Consumers shows 2633.18'. The difference on the East line is the distance from the found 3/4" iron rod to the fence corner post.

I-5 Section Corner, Sections 10,11,14,15, T7N-R8E, Davison Township.

East 22.10' Set GC Remon Nail & Tag, North face 16" Shagbark Hickory  
West 16.34' Found Nail & Tag #11192 North face 10" Shagbark Hickory  
North 28.52' Set GC Remon Nail & Tag West face of 16" Shagbark Hickory  
S45°E 91.15' Northwest corner of wood shed west of house no. 12017 Lapeer Road  
South 113.13 centerline of Lapeer Road

Ratified by Genesee County Peer Group December 8, 1999. I set the standard Bernstein monument {3 1/4" d. brass cap stamped "Genesee County Remonumentation Corner, 1999" with 30" x 2 3/8" O.D. stainless steel tube over 3/4" iron rod.


Signed by

*David J. Kenney*

Date December 27, 1999

Surveyor's Michigan License No.

39083

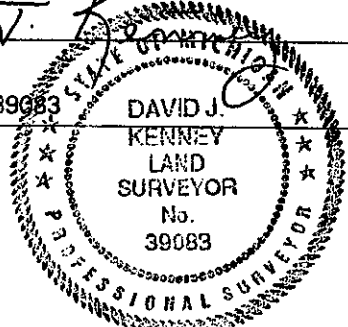

FORM APPROVED BY MICHIGAN STATE BOARD OF LAND SURVEYOR, JAN. 28, 1971  
REVISED MAY 14, 1976  
REVISED JAN., 1983

Ratified by Peer Group in accordance with P.A. 345, 1990

Co. Rep. *Carl Larson*

Date 12-8-99