

SURVEY & REMONUMENTATION **1999 REMONUMENTATION PROGRAM**
LAND CORNER RECORDATION CERTIFICATE
 Filing Requirement of Act 74, Mich. P.A. 1970

MAR 23 2000

For corners in

Mich. State Surveyor

DEC 28 10 38 AM '99

GENESEE COUNTY REGISTER OF DEEDS

L 4358, P. 744

Register of Deeds Stamp & File Number

Genesee County **SECTION** Located In: Davison Corner Code # L-5

- | | | | | | |
|--------------------------------------|---|----|---|----|-----|
| 1. Public Land Survey | T | 7N | R | 8E | L-5 |
| | T | | R | | |
| | T | | R | | |
| | T | | R | | |
| 2. Property Controlling in Section | S | T | R | | |
| | S | T | R | | |
| 3. Miscellaneous Property in Section | S | T | R | | |
| | S | T | R | | |
4. Lot No. _____ Recorded Plat _____
5. Private Claim _____

I, David J. Kenney, in a field survey on December, 1999, do hereby state that under requirements of P.A. 74, Michigan P.A. of 1970, the corner points mentioned in lines 1 and 2 above were in conformance with regulations and rules therefore as required in the current manual of survey instructions of the United States Department of the Interior, Bureau of Land Management or by a decree of a Court of Law and/or that the corner points mentioned in lines 3, 4, and 5 above were in conformance with the rules of the Michigan Board of Land Surveyors or by a Decree of a Court of Law; established, re-established, monumented, re-monumented, recovered, found as expressed below:

NOTE: Not more than 4 corners, all in the same town and range, may be recorded on this certificate

- A. Description of original monument and accessories and/or subsequent restoration:
 1822 G.L.O. Joseph Wampler D.S. - Set post
- B. Description of corner evidence found and/or method applied in restoring or reestablishing corner:
 L-5 Section Corner, Section 12 & 13, T7N-R8E, Davison Township
 Found fence intersection in the east-west and north directions.
 In my research, no record of this corner having been used or any accessories for L-5 were uncovered.

	A	B	C	D	E	F	G	H	I	J	K	L	M
1													
2	6		5		4		3		2		1		
3													
4	7		8		9		10		11		12		
5													
6	18		17		16		15		14		13		
7													
8	19		20		21		22		23		24		
9													
10	30		29		28		27		26		25		
11													
12	31		32		33		34		35		36		
13													

In the field I used the combination of 3 recorded surveys and tax descriptions to recover L-5. The surveys were as follows: 1) Henderson, Bates & Eirich, Inc., L 2122, P. 696 by Benard Henderson, RLS #16041, April, 1981.
 2) CHMP, L 2118, P. 80 by A.F. Miller, RLS #12024, July, 1981.
 3) Gould Engineering, Inc., L 2472, P. 670 by A. Vance Kupisch, RLS #13586

Bernard Henderson shows the northeast corner of Section 13, a bearing along the east line of Section 13 and a bearing along the centerline of Lapeer Road.

A.F. Miller shows the southeast corner of Section 12, a bearing along the south line of Section 12 and distance to the east 1/8 line, also a bearing along the centerline of Lapeer Road.

A. Vance Kupisch shows the northeast corner of Section 13, a bearing along the east line of Section 13, a bearing along the centerline of Lapeer Road with an overall distance to the north-south 1/4 line, and a bearing along the north-south 1/4 line of Section 13.


Using found monumentation along the south line of Lapeer Road from A. Vance Kupisch survey, also the 1/2" iron at the centerline of Lapeer Road and the east line of Section 13, as shown on all 3 surveys and the northeast corner of Section 13 (M-5) as shown on all 3 surveys, I calculated the position of L-5 from the intersection of bearings along the south line of Section 12 and the west line of Section 13. The distance from M-5 to L-5 is 2707.69 feet. From M-5 to the east 1/8 line as per A.F. Miller's survey is 1353.69 feet and 1/2 the distance from M-5 to L-5 is 1353.84 feet.

In setting the 1/2" re-rod with Kraft cap at the calculated position for L-5, the iron fell in the east-west fence line and 1.5' +/- east of the north fence line. The L-5 position is north of Lapeer Road in the woods, there is a small ditch running east-west North of L-5 and a 30' +/- drain running north-south east of L-5, there is no other visible occupation.

L-5 Section Corner, Section 12 & 13, T7N-R8E, Davison Township

- East 15.90' Set GC Nail & Tag in south face 24" Maple
- West 20.00' Set GC Nail & Tag in south face of 24" Maple
- South 17.83' Set GC Nail & Tag in west face 8" Ash
- S20°W 27.85' Set GC Nail & Tag in east face 6" Twin Ash
- North 19.0' centerline of small ditch
- East 91.0' west top bank of 30' +/- wide ditch.
- S01°31'59"E, 314.69' Set P.K. and Kraft tag centerline of Lapeer Road on west line of Section 13
- N88°07'17"E, 2707.69 Found 1" pipe corner Section 13 (M-5)

Signed by *David J. Kenney*

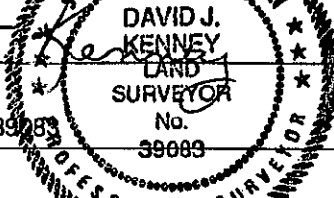

DAVID J. KENNEY
 LAND SURVEYOR
 No. 39083
 PROFESSIONAL SURVEYOR

Surveyor's Michigan License No. 39083

Ratified by Genesee County Peer Group December 8, 1999. I set the standard Bernstein monument (3 1/4" d. brass cap stamped "Genesee County Remonumentation Corner, 1999" with 30" x 2 3/8" O.D. stainless steel tube over Found fence intersection in the east-west and north directions.

Ratified by Peer Group in accordance with P.A. 345, 199
 Co. Rep. *Carl Carlson*
 Date 12-8-99

Date December 27, 1999