

1995 REMONUMENTATION PROGRAM
LAND CORNER RECORDATION CERTIFICATE
 Filing Requirement of Act 74, Mich. P.A. 1970

DEED LIBER 2601 PAGE 260
 REGISTER OF DEEDS
 GENESSEE COUNTY
 JUN 5 10 42 AM '95
 REC'D
 F. RECORDS
 1002
 Register of Deeds Stamp & File Number 9.00
filed rec

For corners in	Genesee (County)	Located In:	Corner Code #
1. Public Land Survey	T 8N R 5E		A-4
	T R		
	T R		
	T R		
2. Property Controlling in Section	S T R		
	S T R		
3. Miscellaneous Property in Sec.	S T R		
	S T R		

SURVEY & REMONUMENTATION

4. Lot No. _____, Recorded Plat _____ APR 29 1996
 5. Private Claims _____
 COMMISSION

	A	B	C	D	E	F	G	H	I	J	K	L	M
1													
2	6	5	4	3	2	1							
3													
4	7	8	9	10	11	12							
5													
6	18	17	16	15	14	13							
7													
8	19	20	21	22	23	24							
9													
10	30	29	28	27	26	25							
11													
12	31	32	33	34	35	36							
13													

I, Jack N. Owens, Prof. Surveyor, in a field survey on September 28, 1995, do hereby certify that under requirements of P.A. 74, Michigan P.A. of 1970, the corner points mentioned in lines 1 and 2 above were in conformance with regulations and rules therefore as required in the current manual of survey instructions of the United States Department of the Interior, Bureau of Land Management or by a decree of a Court of Law and/or that the corner points mentioned in lines 3, 4 and 5 above were in conformance with the rules of the Michigan Board of Land Surveyors or by a Decree of a Court of Law; established, re-established, monumented, re-monumented, recovered, found as expressed below:

NOTE: Not more than 4 corners, all in the same town and range, may be recorded on this certificate.

A. Description of original monument and accessories and/or subsequent restoration:

1930 MNOT - M-13 Construction Plans, no corners shown, no accessories.
 1993 Cert. Surv. - L 2509 pgs 752-756, by Paul N. Brown P933134; set REI rod & cap #33134 2.4' W of phys C/L M-13, and 4 new accessories.


B. Description of corner evidence found and/or method applied in restoring or reestablishing corner:

1995 End 1/2" rod and cap #33134, 2.4' W of phys C/L M-13, and 3 accessories from 1993 (E 1/4 cor. Sec. 12, T8N-R4E, to South at 381.08', and tag #23857 in 12" elm to NE at 73.99', and tag #23857 in 12" elm to SE at 70.22').
 In 1993, Paul N. Brown in a field survey re-established the position of A-4. He did this by first retracing the 1930 survey centerline for 1 mile (1/2 mile North of A-4, and 1/2 mile South of A-4). Feeling confident that he had fixed the location of the survey centerline, he began retracing the township line. There was no apparent occupation to the East of A-4 and subsequently the position was re-established by splitting the mile distance from A-3 to A-5 and setting a REI rod and cap #33134 on line M-3, M-4 T8N-R4E which fell 2.4 feet West of physical centerline of M-13 which is 2.0 feet East of the 1930 survey centerline. While visiting the corner A-4 during the field portion of the 1995 Genesee County Remonumentation program we found a 1/2" rod and cap #33134, 2.4 feet West of the physical centerline of M-13, and three accessories from the 1993 survey.
 Ratified by Genesee Co. Peer Group, December 5, 1995.

C. Description of monument for corner and accessories established to perpetuate locating the position of the corner:

ACCESSORIES:
 South 381.12' E 1/4 cor. Sec. 12, T8N-R4E
 N60°E 74.01' End nail & tag #23857 in NW fc 12" elm
 S75°E 72.24' End nail & tag #23857 in SSW fc 12" elm
 N35°W 88.52' Set pk & Genesee Co. tag in NE fc P/P
 East 49.93' End Gould Eng. "T" Iron

Ratified by Peer Group in accordance with P.A. 245, 1990
 Co. Rep. Carl Carlson
 Date 12-5-95

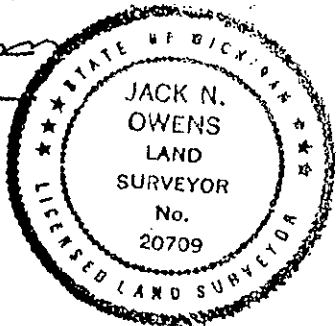

I removed the 1/2" rod & cap #33134 and I cut hole in pavement and installed mon box lift ring and I set the standard Bernsten monument cap SS-A-5-BR-30 (3 1/4" D. brass cap stamped "Genesee County Remonumentation Corner A-4, 20709, 1995") on 18" long x 5/8" re-rod.

Signed by Jack N. Owens
 Surveyor's Michigan License No. 20709

Date Dec 28, 1995