

ratified by Peer Group in accordance with P.A. 345, 1990  
 No. Rep. [Signature]  
 Date 10-25-95

1995 REMONUMENTATION PROGRAM  
 LAND CORNER RECORDATION CERTIFICATE  
 Filing Requirement of Act 74, Mich. P.A. 1970

DEED LIBER 2601 PAGE 276

For corners in Genesee (County) Located In \_\_\_\_\_ Corner Code # \_\_\_\_\_

1. Public Land Survey T 8N R 5E F-5  
 T \_\_\_\_\_ R \_\_\_\_\_  
 T \_\_\_\_\_ R \_\_\_\_\_  
 T \_\_\_\_\_ R \_\_\_\_\_

2. Property Controlling in Section S \_\_\_\_\_ T \_\_\_\_\_  
 S \_\_\_\_\_ T \_\_\_\_\_

3. Miscellaneous Property in Sec. S \_\_\_\_\_ T \_\_\_\_\_  
 S \_\_\_\_\_ T \_\_\_\_\_

4. Lot No. \_\_\_\_\_ Recorded Plat \_\_\_\_\_

5. Private Claims \_\_\_\_\_

GENESEE COUNTY REGISTER OF DEEDS  
 REGISTERED  
 JAN 5 10 42 AM '96  
 1015  
 Register of Deeds Stamp & File Number  
 F. RECORDS  
 11-00  
 file  
 [Signature]

COMMISSION

	A	B	C	D	E	F	G	H	I	J	K	L	M
1													
2	6	5	4	3	2	1							
3													
4	7	8	9	10	11	12							
5													
6	18	17	16	15	14	13							
7													
8	19	20	21	22	23	24							
9													
10	30	29	28	27	26	25							
11													
12	31	32	33	34	35	36							
13													

I, Jack N. Owens, Prof. Surveyor, in a field survey on September 26 19 95, do hereby certify that under requirements of P.A. 74, Michigan P.A. of 1970, the corner points mentioned in lines 1 and 2 above were in conformance with regulations and rules therefore as required in the current manual of survey instructions of the United States Department of the Interior, Bureau of Land Management or by a decree of a Court of Law and/or that the corner points mentioned in lines 3, 4 and 5 above were in conformance with the rules of the Michigan Board of Land Surveyors or by a Decree of a Court of Law; established, re-established, monumented, re-monumented, recovered, found as expressed below:

NOTE: Not more than 4 corners, all in the same town and range, may be recorded on this certificate.


- A. Description of original monument and accessories and/or subsequent restoration:  
 1822, GLO - H. Ball DS, set and 2 accessories  
 1933, GCRC - witnesses; 3/4" pipe, and 4 new accessories  
 1933, GCRC - field notes; no description of monument, measured between corners F-5 & G-5, no accessories  
 1934, GCRC - field notes; no description of monument, 1 new accessory  
 1936, GCRC - field notes; no description of monument, no accessories  
 1970, REX - field sketch; no description of monument, measured between corners G-5 & F-5, and F-6 & F-5, no accessories  
 1973, unrecorded surv. - F-4197-73, by David T. Rowe PS 11192, 1978 L. 1999, Pgs 945-947, by Jan S. Fokens PS fnd 3/4" iron pin in mon. box, and 4 new accessories.  
 1979, Cert. Surv. - L. 2036, Pgs 697-698, by Jan S. Fokens PS 21567; 3/4" iron in mon. box, and 2 new accessories.  
 1980, Cert. Surv. - L. 2094, P 759, by Jan S. Fokens PS 21567; fnd 3/4" pin in mon. box, measured between corners F-5 & F-6, and 1 new accessory  
 1983, Cert. Surv. - L. 2180, Pgs 557-558, by Jan S. Fokens PS 21567, 1985 L. 2228, Pgs 99-100, by David T. Rowe PS 11192; fnd 3/4" rod in mon. box, measured between corners F-5 & E-5, and 3 new accessories.  
 Continued on back

B. Description of corner evidence found and/or method applied in restoring or reestablishing corner:  
 1995 - fnd 3/4" re-rod in mon. box, and 1 accessory from 1934 (gauge line W rail GTRR to W at 411.63), and 1 accessory from 1973 (plat monument to SW at 70.41'), and 2 accories from 1979 (conc nail N end 48" cmp to NE at 52.46', and conc. nail S end 48" cmp at 52.61'), and 1 accessory from 1980 (cut notch 18" cmp to SE at 46.48'), and 1 accessory from 1988 (spike in p/p to SW at 72.24'), and 1 accessory from 1991-1993 (pk & tag in fnc post to NW at 59.86').  
 In 1933 the GCRC noted a 3/4" pipe and 4 accessories. Two of these witnesses were to prominent corners of a brick arch under Stanley Road. This corner appears to have been re-established a the split of the mile measurement. In 1933 the GCRC measured 2623.09 feet between the corners F-5 & G-5. In 1934 the GCRC measured 2623.55 feet between the corners F-5 & E-5, and noted a distance of 411.63 feet to the west rail gauge line of the Grand Trunk Railroad to the west of the corner. In 1973 David T. Rowe, and later in 1978 Jan S. Fokens reported finding a 3/4" iron pin in a monument box and measured to a chiseled "+" in the top NW corner of a concrete headwall. This concrete headwall to the NE, according to its direction and distance, would be in the same location relative to the 3/4" pipe the GCRC had in 1933. I conclude that the concrete headwall was a refurbished portion of the old brick arch under Stanley Road as first noted in 1933 by the GCRC. The 3/4" iron pin in a monument box found in 1973 by David T. Rowe has remained there in the same location (also called a 3/4" rod in a monument box on several occasions) and was recovered in the 1995 Remonumentation Program. In 1990 Rowe Engineering measured 2624.18 feet between the corners F-5 & E-5, which only differs by 0.12 of a foot from a previous measurement by Rowe

C. Description of monument for corner and accessories established to perpetuate locating the position of the corner:  
 Ratified by Genesee Co. Peer Group Oct. 25, 1995

- Accessories:  
 West 411' gauge line West rail GTWRR  
 S45°W 70.46' fnd conc. mon  
 N70°E 52.47' fnd conc. nail in top N end 48" cmp  
 S65°E 52.61' fnd conc. nail in top S end 48" cmp  
 S30°E 46.57' fnd chisl "V" notch in E end 18" cmp  
 S45°W 72.27' fnd spike & flg, and 72.29' fnd pk & tag #32332 in SE fc p/p  
 N60°W 59.88' fnd pk & tag #11192 in E fc fnc post  
 North 33.07' fnd 1/2" rod w/o cap leaning slightly E  
 S45°W 54.50' top center fire hydrant

I removed the 3/4" re-rod and I set the standard Berntsen monument SS-A-5-BR-30 (3 1/4" D. brass cap stamped "Genesee County Remonumentation Corner 20709, 1995") with 24" x 2 3/8" O.D. steel tube in mon. box.

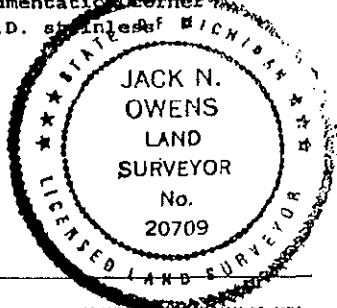

Signed by Jack N. Owens Date Dec. 28, 1995  
 Surveyor's Michigan License No. 20709

A. Description of original monument and accessories and/or subsequent restoration:

1985, REI - Survey calculations worksheet, no description of monument, measured between corners F-5 & F-4, no accessories  
1988, Cert. Surv. - L. 2343, P 150, by Paul N. Brown PS 33134; fnd 3/4" rod in mon box, and 2 new accessories.  
1990, REI - field sketch; fnd 3/4" rod in mon. box, measured between corners F-5 & E-5, no accessories.  
1991, REI - survey worksheet, no description of monument, measured between corners F-5 & G-5, no accessories  
1991-1993, Cert. Surv. - 1991 L. 2448, Pgs 193-195, 1992 L. 2464, Pgs 482-484 1993 L. 2522, Pgs 924-925, 1993 L. 2522, Pgs 926-928, all done by Paul N. Brown PS 22134; fnd 3/4" rod in mon. box, measured between corners, F-5 & G-5, and F-5 & F-6, and 1 new accessory.

B. Description of corner evidence found and/or method applied in restoring or reestablishing corner:

Engineering in 1985, and 0.63 of a foot from the 1934 measurement by the GCRC. In 1990 & 1992 Rowe Engineering measured 2623.76 feet between the corners F-5 & G-5, which only differs by 0.67 of a foot from the 1933 measurement by the GCRC. As noted above the 1934 GCRC distance of 411.63 feet to the West gauge line of the GTRR is nearly identical to our measurement observed in 1995 of 411.65 feet from the 3/4" rod in the monument box (differing by only 0.02'). By virtue of the 1973 & 1978 measurements to a corner of a concrete headwall (now removed) to the NE at 13.86 feet, most likely being a refurbished portion of the old brick arch under Stanley Road; the close agreement of the 1/2 mile distances between the corners E-5, F-5, and G-5; and finally the close agreement of the measurement to the gauge line of the west rail of the GTRR to the West of the corner, I conclude that the 3/4" rod in a monument box we found in 1995 is in the same position as the 3/4" pipe found or set in 1933 by the GCRC and accept it as a careful and faithful re-establishment of the position of the original corner.

SURVEY &  
REMONUMENTATION

APR 29 1996

COMMISSION