

Ratified by Peer Group in accordance with P.A. 848, 1990
 1995 REMONUMENTATION PROGRAM
 LAND CORNER RECORDATION CERTIFICATE
 No. Rep. Carl [Signature] Filing Requirement of Act 74, Mich. P.A. 1970
 Date 12-5-95

DEED BOOK 2601 PAGE 272

GENESEE COUNTY REGISTER OF DEEDS

JAN 5 10 42 AM '96

RECORDED

RECORDED

1013

Register of Deeds Stamp & File Number

1100
 Dileza
 Doe

For corners in Genesee (County) Located In: _____ Corner Code # _____

1. Public Land Survey T 8N R 5E K-4
 T R
 T R
 T R

2. Property Controlling in Section S T R
 S T R
 S T R

3. Miscellaneous Property in Sec. S T R
 S T R

4. Lot No. _____ Recorded Plat _____

5. Private Claims _____

SURVEY & REMONUMENTATION

APR 29 1996

COMMISSION

I, Jack N. Owens, Prof. Surveyor, in a field survey on September 30, 1995, do hereby certify that under requirements of P.A. 74, Michigan P.A. of 1970, the corner points mentioned in lines 1 and 2 above were in conformance with regulations and rules therefore as required in the current manual of survey instructions of the United States Department of the Interior, Bureau of Land Management or by a decree of a Court of Law and/or that the corner points mentioned in lines 3, 4 and 5 above were in conformance with the rules of the Michigan Board of Land Surveyors or by a Decree of a Court of Law, established, re-established, monumented, re-monumented, recovered, found as expressed below.

NOTE: Not more than 4 corners, all in the same town and range, may be recorded on this certificate.

A Description of original monument and accessories and/or subsequent restoration:

- 1822 GLO - H. Ball, DS: Set 1/4 sec. post and 2 accessories.
- 1890 GCSR - Moses Middleton C.S.: set post at split of measurement on st. line between corners K-3 to K-5, no accessories.
- 1906 GCSR - Unknown Co. Sur.; reset (not described but several set cors. = oak stakes) (by statute) in center of old fence line, 1 new accessory.
- 1935 ca., GCRC - Fnd tile, 3 new accessories (all oak trees).
- 1971 Cert. Surv. L 1810 p 760-761 & L 1810 p 802-803 by David T. Rowe, PS 11192; set "T" iron (project broken down 1977, fld notes - fnc E to N-S fnc), 4 new accessories and measured between corners K-5 and K-4.
- 1986 Cert Surv. L 2276 p 71-72 by Jack N. Owens, PS20709; fnd "T" iron and 4 old accessories (2 = 1935 trees).

(Continued on back)

B. Description of corner evidence found and/or method applied in restoring or reestablishing corner:

In 1890 the Genesee Co. Surv. Moses Middleton re-established the corner at the proportionate position on line (as shown by continuous bearing and equal distance from corners K-5 to K-4 to K-3) and set a post. In 1906 an unknown Co. Surv. claimed to "reset under statute in center of old fence line" with 1 accessory, a 14" W. oak at 76 links which still stands, now being a dead 36" W. oak. The GCRC (circa 1935) witness book shows they recovered a tile and measured to 3 new accessories, 3 oaks recovered in 1995. The field crew, Jim Fink and Dave Keller, found the distances from the 4 oaks located a position approximately 4 ft. S of the "T" iron (set by REI in 1971, a position determined by projecting the broken-down SW 1/4 line fence E to the standing NS fence, with

(Continued on back)


C. Description of monument for corner and accessories established to perpetuate locating the position of the corner:

Ratified by Genesee County Peer Group, December 5, 1995

ACCESSORIES:

- N75°E 52.07' Fnd nail/tag 32332 S fc 37" dead W. oak
- S40°W 21.59' Fnd nail/tag (overgrown 0.15') NE fc 27" oak
- S45°E 33.77' Fnd nail/tag 11192 NE fc 31" oak
- S65°E 51.57' Set 60 d/GC Remontag N fc 22" oak
- N05°E 55.50' Fnd nail/tag 11192 E fc 14" oak
- S89°W 10.45' Fnd nail/tag 11192 S fc 20" maple
- 10.59' Fnd nail N fc

I set the standard Bernsten monument SS-A-5-BR-30 (3 1/4" D. brass cap stamped "Genesee County Remonumentation Corner 20709, 1995" with 30" x 2 3/8" O.D. stainless steel tube 0.5' below grade. anchor post.

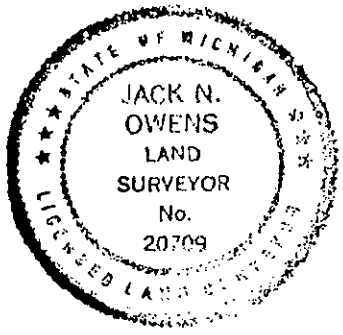

Signed by Jack N. Owens
 Surveyor's Michigan License No. 20709

Date Dec 28, 1995

SURVEY &
REMONUMENTATION

MAY 31 2000

SECTION

DEED
LIBER 2601 PAGE 273

A. Description of original monument and accessories and/or subsequent restoration:

- 1987 - 1988 Cert. Surv & LCRC - L 2316 p 255-256 & L 2316 p 67 by Gilbert G. Bonno, PS 32332; L 2335 p 674 by Mark L. VanRaemdonck, PS24622; fnd "T" iron and 4 new accessories (2 in 1971-86 trees and 3 also = 1906 and 1935 trees).
- 1992 Cert. surv. unrecorded, by Christopher W. Newman, PS24607; fnd "T" iron and 4 new accessories (4 in 1987 trees, 2 same as 1971 and 1935 trees, 1 same as 1906 trees).
- 1993-1994 Cert survs - L 2491 p 254, L 2551 p 644 by Paul N. Brown, PS33134; fnd "T" iron and 3 new accessories (3 in 1971 trees, 2 same as 1935 trees which are also 1987 and 1992 trees, 1 also same as 1987 and 1982 tree).

B. Description of corner evidence found and/or method applied in restoring or reestablishing corner:

no evidence of the EW fnc existing closer than 500'±). Upon excavation they found remnants of a 4" dia. oak post directly under the NS fence (fragile but firm 1 ft. below grade, smaller base, possibly pointed at 2 ft. down-deteriorating wood) as well as piece of vitrified tile. The post was the monument called for in 1890 by M. Middleton, C.S. and the 1906 C.S. also set several oak stakes in his survey, and the GCRC noted the tile in 1935. The "T" iron set by Rowe Engineering in 1971 is 3.91' N, being set by projecting a broken-down fence. The NS fence has an anchor post only 1.7' N of the recovered remnants. The "T" iron has been used in numerous surveys since 1971 with many accessories, all being in the same trees, often when the old nail was overgrown. Of the 7 trees used 4 are the 1890 and 1935 trees which would have allowed recovery of the corner at any time. The distances from corners K-5 to K-4 to K-3 are nearly identical, 40.45 1/2 ch. (2670.0') for both in 1890, 40.47 ch. (2671.0') for both in 1906 vs 2673.38' (40.51 ch) and 2672.51' (40.49 ch), respectively, in 1987 and 1994 EDM measurements. The recovered position is only 0.4' N of the "split" and 1.5' W of a straight line from K-5 to K-3. both of these corners were stones indicating long perpetration by Co. Surveyors 100 to 130 years ago. Upon review of this evidence I conclude that the recovered post remnants is a careful and faithful re-established position of the original corner. The 1971 "T" iron position is and will remain a property controlling corner.

T&N-RSE K-4