

MAY 29 1997

COMMISSION

1996 REMONUMENTATION PROGRAM

MASTER LIBER 3436 PAGE 802

LAND CORNER RECORDATION CERTIFICATE
Filing Requirement of Act 74, Mich. P.A. 1970

RECORDED
RECEIVED
DEC 30 11 37 AM '96

For corners in
Genesee

(County)

Located In:

Corner Code ##

- 1. Public Land Survey T 8N R 6E 1-4
T _____ R _____
T _____ R _____
T _____ R _____
- 2. Property Controlling S _____ T _____ R _____
in Section S _____ T _____ R _____
- 3. Miscellaneous S _____ T _____ R _____
Property in Sec. S _____ T _____ R _____

83525

Register of Deeds Stamp & File Number

- 4. Lot No. _____, Recorded Plat _____
- 5. Private Claims _____

	A	B	C	D	E	F	G	H	I	J	K	L	M
2	6		5		4		3		2		1		
3													
4	7		8		9		10		11		12		
5													
6	18		17		16		15		14		13		
7													
8	19		20		21		22		23		24		
9													
10	30		29		28		27		26		25		
11													
12	31		32		33		34		35		36		
13													

Kevin B. Cleaver P.S. In a field survey on November 22, 19 96, do hereby certify that under requirements of P.A. 74, Michigan P.A. of 1970, the corner points mentioned in lines 1 and 2 above were in conformance with regulations and rules therefore as required in the current manual of survey instructions of the United States Department of the Interior, Bureau of Land Management or by a decree of a Court of Law and/or that the corner points mentioned in lines 3, 4 and 5 above were in conformance with the rules of the Michigan Board of Land Surveyors or by a Decree of a Court of Law; established, re-established, monumented, re-monumented, recovered, found as expressed below:

NOTE: Not more than 4 corners, all in the same town and range, may be recorded on this certificate.

A. Description of original monument and accessories and/or subsequent restoration:

- 1821, GLO Set post, with two (2) accessories
- Date ? Gould Engineering, Inc. records iron in pavement, with six (6) accessories
- June 2, 1965 Recorded plat of "Ina Acres" Liber 41, Page 27
- June 5, 1979 Certified survey, Liber 2057, Pages 442, 443 and 444, found iron in pavement with four (4) accessories

B. Description of corner evidence found and/or method applied in restoring or reestablishing corner:

Found nail and flagging in asphalt; found one (1) accessory from recorded plat of "Ina Acres"; found one (1) accessory from certified survey Liber 2057, Pages 442, 443, and 444.

The monument found was ratified by the Genesee County Peer Review Committee on October 30, 1996, as the accepted corner.


Ratified by Peer Group in accordance with P.A. 345, 1990
Co. Rep. [Signature]
Date 10-30-96

C. Description of monument for corner and accessories established to perpetuate locating the position of the corner:

Set in concrete the standard Bernsten Monument SS-A-5-BR-30, with 3 1/4" brass cap stamped Genesee County Remonumentation Corner 1996, #29242 in a monument box.

- N 85° W 61.43' Set Genesee County Remonumentation tag in North Face of 30" oak
- N 30° E 83.82' Set Genesee County Remonumentation tag in Northeast face of power pole.
- N 30° W 81.54' Set Genesee County Remonumentation tag in Southeast face of power pole.
- S 65° E 60.79' Set Genesee County Remonumentation tag in Southwest face of power pole.

Signed by Kevin Banfield Cleaver
Kevin Banfield Cleaver, P.S.,
Surveyor's Michigan License No. 29242

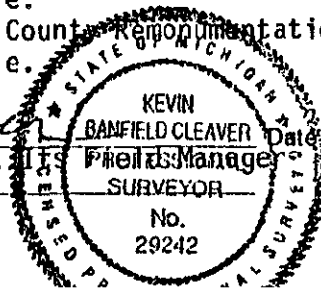

Date Nov 22, 1996