

**SURVEY & REMONUMENTATION**

MAY 31 2000

**SECTION**

**1996 REMONUMENTATION PROGRAM  
LAND CORNER RECORDATION CERTIFICATE  
Filing Requirement of Act 74, Mich. P.A. 1970**

MASTER LIBER 3436 PAGE 798

For corners in

Genesee  
(County)

Located In:

Corner Code =#

- 1. Public Land Survey      T 8N R 6 E      K-5
- T    R
- T    R
- T    R
- 2. Property Controlling    S    T    R
- in Section                    S    T    R
- 3. Miscellaneous            S    T    R
- Property in Sec.           S    T    R

83521

RECORDED  
REGISTERED  
OCTOBER 30 11 37 AM '96  
GENESEE COUNTY REGISTERED DEEDS  
FILED & RECORDED  
900

**Register of Deeds Stamp & File Number**

- 4. Lot No. \_\_\_\_\_, Recorded Plat \_\_\_\_\_
- 5. Private Claims \_\_\_\_\_

Kevin B. Cleaver P.S. in a field survey on November 22, 1996

do hereby certify that under requirements of P.A. 74, Michigan P.A. of 1970, the corner points mentioned in lines 1 and 2 above were in conformance with regulations and rules therefore as required in the current manual of survey instructions of the United States Department of the Interior, Bureau of Land Management or by a decree of a Court of Law and/or that the corner points mentioned in lines 3, 4 and 5 above were in conformance with the rules of the Michigan Board of Land Surveyors or by a Decree of a Court of Law; established, re-established, monumented, re-monumented, recovered, found as expressed below:

**NOTE: Not more than 4 corners, all in the same town and range, may be recorded on this certificate.**

	A	B	C	D	E	F	G	H	I	J	K	L	M
2	6		5		4		3		2		1		
3													
4	7		8		9		10		11		12		
5													
6	18		17		16		15		14		13		
7													
8	19		20		21		22		23		24		
9													
10	30		29		28		27		26		25		
11													
12	31		32		33		34		35		36		
13													

**A. Description of original monument and accessories and/or subsequent restoration:**

- 1821, GLO                      Set post with two (2) accessories
- Date ?                        GEI records, pipe with three (3) accessories
- Date ?                        GEI records, fnd seven (7) accessories
- 1964                            GEI records, 1/2" rod with four (4) accessories
- July 23, 1973                Survey, L-1876, P-897 and 898, fnd 1" solid bar in monument box with four (4) accessories.
- Jan 10, 1985                LCRC L-2213, P-797, fnd 1/2 re-rod with three (3) accessories
- Jan 16, 1985                LCRC L-2276, P-370, fnd 3/4" rod with four (4) accessories
- July 15, 1988                Survey, L-2333, P-764 and 765, fnd 1" solid bar in monument box with four (4) accessories

**B. Description of corner evidence found and/or method applied in restoring or reestablishing corner:**

Found 1" solid rod in monument box; found four (4) accessories from Gould Engineering, Inc. records; found four (4) accessories from certified survey, Liber 1876, Pages 897 and 898; found three (3) accessories from LCRC, Liber 2213, Page 797; found three (3) accessories from LCRC, Liber 2276, Page 370; found four (4) accessories from certified survey, Liber 2333, Pages 764 and 765.

The monument found was ratified by the Genesee County Peer Review Committee on October 30, 1996, as the accepted corner.


**Ratified by Peer Group in accordance with P.A. 345, 1990**  
Co. Rep. Cal Lamb  
Date 10-30-96

**C. Description of monument for corner and accessories established to perpetuate locating the position of the corner:**

Set the standard Bernsten monument SS-A-5-BR-30 with 3/4" brass cap stamped Genesee County remonumentation corner 1996, #29242 at the location of the found 1" rod set 1" rod below and next to remon corner to create the magnetic field in mon box.

- N 42° W      55.25'      Found MSHD tag in power pole
- N 30° E      64.56'      Found Delta tag in west face of power pole
- S 30° W      56.82'      Set Genesee County remonumentation tag in southeast face of power pole
- South        56.65'      Set chiseled 'x' of gatewell east of entrance to water plant

Signed by Kevin Banfield Cleaver  
Kevin Banfield Cleaver, P.S., It  
Surveyor's Michigan License No. 29242

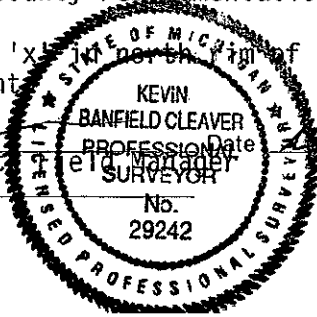

90