

SURVEY & REMONUMENTATION

MAY 31 2000

SECTION _____

1996 Remonumentation Program
LAND CORNER RECORDATION CERTIFICATE MASTER 3434 PAGE 288
 Filing Requirement of Act 74, Mich. P.A. 1970 LIBER

For corners in
 Genesee

Located In: Corner Code #

(county)	Located In:	Corner Code #
1. Public Land Survey	T 8N R 8E	A4
	T _____ R _____	_____
	T _____ R _____	_____
	T _____ R _____	_____
2. Property Controlling in Section	S _____ T _____ R _____	_____
	S _____ T _____ R _____	_____
3. Miscellaneous Property in Sec.	S _____ T _____ R _____	_____
	S _____ T _____ R _____	_____

RECORDED
 REGISTERED
 Dec 23 2 07 PM '96
 82425
 Register of Deeds Stamp & File Number
900 file & rec

4. Lot No. _____, Recorded Plat _____

5. Private Claims _____

I, James E. Kovas, in a field survey on September 24, 1996, do hereby certify that under requirements of P.A. 74, Michigan P.A. of 1970, the corner points mentioned in lines 1 and 2 above were in conformance with regulations and rules therefore as required in the current manual of survey instructions of the United States Department of the Interior, Bureau of Land Management or by a decree of a Court of Law and/or that the corner points mentioned in lines 3, 4 and 5 above were in conformance with the rules of the Michigan Board of Land Surveyors or by a Decree of a Court of Law; established, re-established, monumented, re-monumented, recovered, found as expressed below:

	A	B	C	D	E	F	G	H	I	J	K	L	M
2	8	5	4	3	2	1							
3													
4	7	8	9	10	11	12							
5													
6	10	17	16	15	14	13							
7													
8	19	20	21	22	23	24							
9													
10	30	29	28	27	26	25							
11													
12	31	32	33	34	35	36							
13													

NOTE: Not more than 4 corners, all in the same town and range, may be recorded on this certificate.

A. Description of original monument and accessories and/or subsequent restoration:

- A-4
- 1821 - G.L.O. Set 1/4 Post WIT: S80°E 18 Lks. Beech; S73°W 20 Lks. Sassafrass
- 1994 - Genesee Co. Road Comm., Road Plans, Set 1/2" Iron Rod in Monument Box, no accessories.

Distance: A-4 to A-5 = 2572.03' (Wade-Trim)
 A-4 to A-3 = 2663.79' (Wade-Trim)

B. Description of corner evidence found and/or method applied in restoring or reestablishing corner:

A-4 Found 1/2" Iron Rod in Monument Box


Retified by Peer Group in accordance with P.A. 345, 1990
 Co. Rep. Carl Carlson
 Date 11-20-96

The monument found was ratified by Peer Review Committee on December 4, 1996, as the accepted corner.

C. Description of monument for corner and accessories established to perpetuate locating the position of the corner:

A-4 Set 2" X 30" Iron Pipe with Brass Genesee Co. Remon Cap, in existing Monument Box

- WIT:
- N58°W 32.83' Set 60d Nail/ Genesee Co. Remon Tag N.Face Fence Post
 - N88°E 52.88' Set P.K. Nail/ Genesee Co. Remon Tag S.Face U.Pole
 - N50°E 52.20' Set 60d Nail/ Genesee Co. Remon Tag NW Face 10" Cherry
 - N35°W 43.62' Set P.K. Nail/ Genesee Co. Remon Tag NE Face U.Pole
 - N80°E 45.36' Set 60d Nail/ Genesee Co. Remon Tag N.Face 10" Boxelder
 - South 100.0' South end of Bituminous Pavement (Vassar Road Dead End)
 - South 103.69' Fnd 1/2" Iron Rod in Monument Box (E1/4 Post, Sec 12, T8N, R7E)

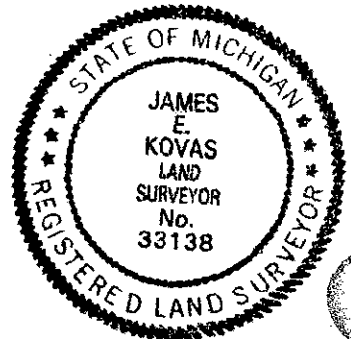

Signed by James E. Kovas Date December 20, 1996

Surveyor's Michigan License No. 33138