

**SURVEY & REMONUMENTATION**

MAY 31 2000

SECTION

1996 Remonumentation Program  
**LAND CORNER RECORDATION CERTIFICATE**  
 Filing Requirement of Act 74, Mich. P.A. 1970

MASTER LIBER 3437 PAGE 601

For corners in

| Genesee<br>(county)                | Located In:             | Corner Code # |
|------------------------------------|-------------------------|---------------|
| 1. Public Land Survey              | T <u>8N</u> R <u>8E</u> | <u>A-5</u>    |
|                                    | T _____ R _____         | _____         |
|                                    | T _____ R _____         | _____         |
|                                    | T _____ R _____         | _____         |
| 2. Property Controlling in Section | S _____ T _____ R _____ | _____         |
|                                    | S _____ T _____ R _____ | _____         |
| 3. Miscellaneous Property in Sec.  | S _____ T _____ R _____ | _____         |
|                                    | S _____ T _____ R _____ | _____         |

RECORDED  
 REGISTERED  
 DEC 30 3 12 PM '96  
 87758  
 Register of Deeds Stamp & File Number  
*900*

4. Lot No. \_\_\_\_\_, Recorded Plat \_\_\_\_\_  
 5. Private Claims \_\_\_\_\_

I, James E. Kovas, in a field survey on December 4, 1996, do hereby certify that under requirements of P.A. 74, Michigan P.A. of 1970, the corner points mentioned in lines 1 and 2 above were in conformance with regulations and rules therefore as required in the current manual of survey instructions of the United States Department of the Interior, Bureau of Land Management or by a decree of a Court of Law and/or that the corner points mentioned in lines 3, 4 and 5 above were in conformance with the rules of the Michigan Board of Land Surveyors or by a Decree of a Court of Law; established, re-established, monumented, re-monumented, recovered, found as expressed below:

|    | A  | B | C  | D | E  | F | G  | H | I  | J | K  | L | M |
|----|----|---|----|---|----|---|----|---|----|---|----|---|---|
| 2  | 6  |   | 5  |   | 4  |   | 3  |   | 2  |   | 1  |   |   |
| 3  |    |   |    |   |    |   |    |   |    |   |    |   |   |
| 4  | 7  |   | 8  |   | 9  |   | 10 |   | 11 |   | 12 |   |   |
| 5  |    |   |    |   |    |   |    |   |    |   |    |   |   |
| 6  | 18 |   | 17 |   | 16 |   | 15 |   | 14 |   | 13 |   |   |
| 7  |    |   |    |   |    |   |    |   |    |   |    |   |   |
| 8  | 19 |   | 20 |   | 21 |   | 22 |   | 23 |   | 24 |   |   |
| 9  |    |   |    |   |    |   |    |   |    |   |    |   |   |
| 10 | 30 |   | 29 |   | 28 |   | 27 |   | 26 |   | 25 |   |   |
| 11 |    |   |    |   |    |   |    |   |    |   |    |   |   |
| 12 | 31 |   | 32 |   | 33 |   | 34 |   | 35 |   | 36 |   |   |
| 13 |    |   |    |   |    |   |    |   |    |   |    |   |   |

**NOTE: Not more than 4 corners, all in the same town and range, may be recorded on this certificate.**

**A. Description of original monument and accessories and/or subsequent restoration:**

A-5  
 1821 - G.L.O. Set Corner WIT: S49°W 16 Lks. Tree; N80°E 24 Lks. Tree

Ratified by Peer Group in accordance with P.A. 345, 1990  
 Co. Rep. Land  
 Date 12-11-96

**B. Description of corner evidence found and/or method applied in restoring or reestablishing corner:**


A-5 Lost Corner  
 Corner re-established by tying in corners A-3 thru A-6, T8N, R8E, Richfield Township, to establish Township line and hold GLO closing distance of 1.15 Chains (99.66') North of M-5, T8N, R7E, Genesee Township.

Distances: A-5 to A-4 = 2572.03' (Wade-Trim)  
 A-5 to A-6 = 2635.39' (Wade-Trim)  
 A-5 to M-5, T8N, R7E = 99.66' (1.15 Chains)

The re-established position was ratified by Peer Review Committee on December 11, 1996, as the accepted corner.

**C. Description of monument for corner and accessories established to perpetuate locating the position of the corner:**

A-5 Set 2" X 30" Iron Pipe with Brass Genesee Co. Remonumentation Cap  
 WIT: N15°E 18.90' 60d Nail/ Genesee Co. Remon Tag W.Face 12" Elm  
 S05°E 25.98' 60d Nail/ Genesee Co. Remon Tag W.Face 12" Maple  
 West 30.23' 60d Nail/ Genesee Co. Remon Tag N.Face 12" Pine  
 N60°E 10.82' 60d Nail/ Genesee Co. Remon Tag SE Face 4" Elm  
 South 99.66' Fnd Genesee Co. Remon Monument, M-5, T8N, R7E, Genesee Twp.

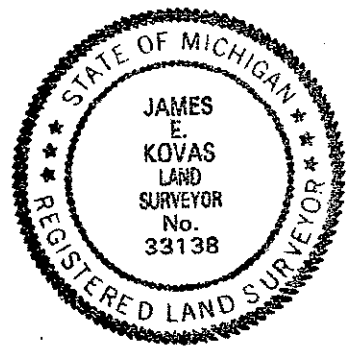

Signed by James E. Kovas Date December 27, 1996

Surveyor's Michigan License No. 33138