

MAY 20 1997

COMPASSION

1996 Remonumentation Program
LAND CORNER RECORDATION CERTIFICATE
Filing Requirement of Act 74, Mich. P.A. 1970

MASTER LIBER 3434 PAGE 289

For corners in

_____ Genesee _____ (county)	Located In:	Corner Code #
1. Public Land Survey	T 8N R 8E	A-6
	T _____ R _____	_____
	T _____ R _____	_____
	T _____ R _____	_____
2. Property Controlling in Section	S _____ T _____ R _____	_____
	S _____ T _____ R _____	_____
3. Miscellaneous Property in Sec.	S _____ T _____ R _____	_____
	S _____ T _____ R _____	_____

82426

Dec 23 2:07 PM '96

RECORDED
FILED

Register of Deeds Stamp & File Number

4. Lot No. _____, Recorded Plat _____

5. Private Claims _____

I, James E. Kovas, in a field survey on December 4, 1996, do hereby certify that under requirements of P.A. 74, Michigan P.A. of 1970, the corner points mentioned in lines 1 and 2 above were in conformance with regulations and rules therefore as required in the current manual of survey instructions of the United States Department of the Interior, Bureau of Land Management or by a decree of a Court of Law and/or that the corner points mentioned in lines 3, 4 and 5 above were in conformance with the rules of the Michigan Board of Land Surveyors or by a Decree of a Court of Law; established, re-established, monumented, re-monumented, recovered, found as expressed below:

	A	B	C	D	E	F	G	H	I	J	K	L
2	6		5		4		3		2		1	
3												
4	7		8		9		10		11		12	
5												
6	16		17		18		15		14		13	
7												
8	19		20		21		22		23		24	
9												
10	30		29		28		27		26		25	
11												
12	31		32		33		34		35		36	
13												

NOTE: Not more than 4 corners, all in the same town and range, may be recorded on this certificate.

A. Description of original monument and accessories and/or subsequent restoration:
A-6

1821 - G.L.O. Set 1/4 Post WIT: N4°W 18 Lks. Beech; S29°E 17 Lks. Beech

1980 - CHMP, Survey (Liber 2090, Page 874) T-Iron WIT: N20°E 96.81' Nail/ Tag 18" B.Walnut; S85°E 28.89' Nail/ Tag 18" B.Walnut; S35°E 63.93' Nail/ Tag 30" B.Walnut; S20°W 67.80' County Road Sign.

Distances: A-6 to A-7 = 2644.78' (Wade-Trim)
A-6 to A-5 = 2635.39' (Wade-Trim)

B. Description of corner evidence found and/or method applied in restoring or reestablishing corner:

A-6 Found T-Iron in Monument Box

WIT: N20°E 96.81' Fnd Nail/ Tag 18" B.Walnut
S85°E 28.89' Fnd Nail/ Tag 18" B.Walnut
S35°E 63.93' Fnd Nail/ Tag 30" B.Walnut

Ratified by Peer Group in accordance with P.A. 345, 1990


Co. Rep. Carl Kahn
Date 11-6-96

The monument found was ratified by Peer Review Committee on December 4, 1996, as the accepted corner.

C. Description of monument for corner and accessories established to perpetuate locating the position of the corner:

A-6 Set 2" X 30" Iron Pipe with Brass Genesee Co. Remon Cap

WIT: S60°E 29.74' Set 60d Nail/ Genesee Remon Tag S.Face 18" B.Walnut
N13°E 97.08' Set 60d Nail/ Genesee Remon Tag W.Face 20" B.Walnut
N70°W 35.09' Set 60d Nail/ Genesee Remon Tag S.Face 10" Elm
N50°E 43.44' Fnd 1/2" Iron Rod (Prop. Cor)
South 100.80' Fnd 1/2" Iron Rod (E1/4 Cor, Sec 13, T8N, R7E)

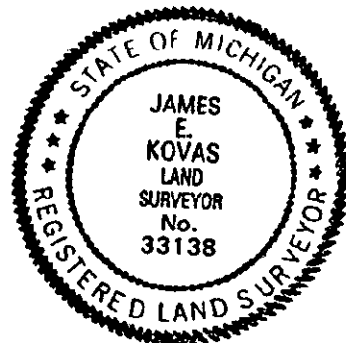

Signed by James E. Kovas Date December 20, 1996

Surveyor's Michigan License No. 33138