


MAY 2 1997

1996 Remonumentation Program
LAND CORNER RECORDATION CERTIFICATE
 Filing Requirement of Act 74, Mich. P.A. 1970 MASTER LIBER 3434 PAGE 292

For corners in

_____ Genesee _____	Located In:	Corner Code #
(county)		
1. Public Land Survey	T 8N R 8E	C-4
	T _____ R _____	_____
	T _____ R _____	_____
	T _____ R _____	_____
2. Property Controlling in Section	S _____ T _____ R _____	_____
	S _____ T _____ R _____	_____
3. Miscellaneous Property in Sec.	S _____ T _____ R _____	_____
	S _____ T _____ R _____	_____

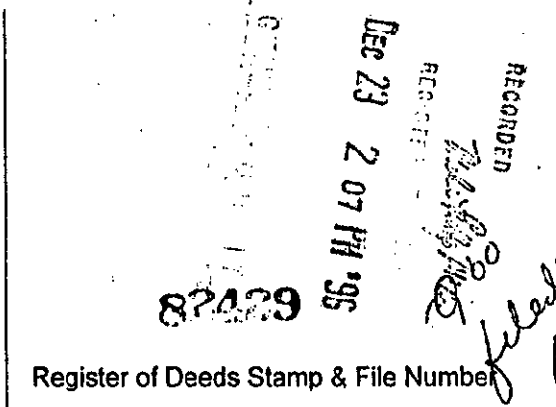

4. Lot No. _____, Recorded Plat _____
5. Private Claims _____

I, James E. Kovas, in a field survey on September 24, 1996, do hereby certify that under requirements of P.A. 74, Michigan P.A. of 1970, the corner points mentioned in lines 1 and 2 above were in conformance with regulations and rules therefore as required in the current manual of survey instructions of the United States Department of the Interior, Bureau of Land Management or by a decree of a Court of Law and/or that the corner points mentioned in lines 3, 4 and 5 above were in conformance with the rules of the Michigan Board of Land Surveyors or by a Decree of a Court of Law; established, re-established, monumented, re-monumented, recovered, found as expressed below:

A	B	C	D	E	F	G	H	I	J	K	L
2	6	5	4	3	2						
3											
4	7	8	9	10	11						
5											
6	16	17	18	15	14						
7											
8	19	20	21	22	23	24					
9											
10	30	29	28	27	26	25					
11											
12	31	32	33	34	35	36					
13											

NOTE: Not more than 4 corners, all in the same town and range, may be recorded on this certificate.

A. Description of original monument and accessories and/or subsequent restoration:

- C-4 1821 - G.L.O. Set 1/4 Post, WIT: S85°W 13 Lks, Beech; S27°E 20 Lks, Beech.
 1971 - Rowe Eng., Iron in Mon. Box, no accessories
 1972 - American Civil Engineers, Survey (L.1817, P.472) 1" Iron Pipe in Mon. Box, WIT: S35°W 133.10' NE Corner House# 7247; West 49.55' Center of Conc. R/W Marker; N40°W 93.35' NE Corner House# 7263.
 1974 - Rowe Engineering, Survey, 1" Iron Pipe in Mon. Box, no accessories
 1974 - Lyal H. Howison, PS#1840, Survey (L.1897, P.892) Mon. Box, no accessories

C-4 to C-5: 2640.00' G.L.O. 1821; 2644.67' Rowe Eng. 1995; 2644.64' Wade-Trim, 1996

B. Description of corner evidence found and/or method applied in restoring or reestablishing corner:


- C-4 Found 1" Iron Pipe in Monument Box
 WIT: East 60.05' Fnd Concrete Plat Monument
 S35°W 132.90' Fnd NE Corner House# 7247
 West 49.75' Fnd Center of Concrete R/W Marker
 N40°W 93.44' Fnd NE Corner House# 7263

Ratified by Peer Group in accordance with P.A. 345, 1990
 Co. Rep. Carl Carter
 Date 10-30-96

The monument found was ratified by the Peer Review Committee on October 30, 1996, as the accepted corner.

C. Description of monument for corner and accessories established to perpetuate locating the position of the corner:

- C-4 Set 2" X 30" Iron Pipe with Brass Genesee County Remonumentation Cap in Monument Box at location of 1" Iron Pipe
 East 60.05' Plat Concrete Monument
 S35°W 132.90' NE Corner House #7247
 West 49.75' Center of State Highway Concrete R/W Marker
 N40°W 93.44' NE Corner House #7263

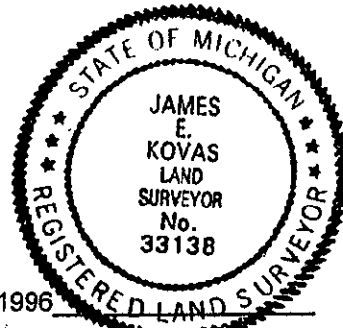

Signed by James E. Kovas Date December 20, 1996