

MAY 20 1997

1996 Remonumentation Program
LAND CORNER RECORDATION CERTIFICATE
Filing Requirement of Act 74, Mich. P.A. 1970

MASTER LIBER 3434 PAGE 293

For corners in

_____ Genesee _____ (county)	Located In:	Corner Code #
1. Public Land Survey	T 8N R 8E	C-5
	T _____ R _____	_____
	T _____ R _____	_____
	T _____ R _____	_____
2. Property Controlling in Section	S _____ T _____ R _____	_____
	S _____ T _____ R _____	_____
3. Miscellaneous Property in Sec.	S _____ T _____ R _____	_____
	S _____ T _____ R _____	_____

RECORDED
REGISTERED
DEC 23 2 07 PM '96
82430
Register of Deeds Stamp & File Number

4. Lot No. _____, Recorded Plat _____

5. Private Claims _____

I, James E. Kovas, in a field survey on September 24, 1996, do hereby certify that under requirements of P.A. 74, Michigan P.A. of 1970, the corner points mentioned in lines 1 and 2 above were in conformance with regulations and rules therefore as required in the current manual of survey instructions of the United States Department of the Interior, Bureau of Land Management or by a decree of a Court of Law and/or that the corner points mentioned in lines 3, 4 and 5 above were in conformance with the rules of the Michigan Board of Land Surveyors or by a Decree of a Court of Law; established, re-established, monumented, re-monumented, recovered, found as expressed below:

A	B	C	D	E	F	G	H	I	J	K	L
2	6	5	4	3	2						
3											
4	7	8	9	10	11						
5											
6	18	17	16	15	14						
7											
8	19	20	21	22	23						
9											
10	30	29	28	27	26						
11											
12	31	32	33	34	35						
13											

NOTE: Not more than 4 corners, all in the same town and range, may be recorded on this certificate.

A. Description of original monument and accessories and/or subsequent restoration:

- C-5 1821 - G.L.O. Set Corner, no accessories
- 1965 - Genesee Co. Road Comm. Section Notes, Concrete Post WIT: NE 47.89' 24" Maple; East 64.5' 6" Cherry; SE 39.24' Nail/Blaze 30" Elm; SSE 74.45' 14" Elm; SW 96.43' 30" Willow; SW 63.7' 40" Willow; WNW 71.3' 36" Poplar.
- 1995 - Rowe Engineering, Survey (L.2576, P.128-129), 3/4" Iron Pipe in Monument Box WIT: S70°W 64.46' Nail/Tag# 11192 N.Face 54" Cottonwood; N40°W 73.63' Nail/Tag#11192 SW Face U.Pole; N65°W 68.47' Nail/Tag# 11192 S.Face Twin 14" Tree; N25°E 65.87' Nail/Tag#23857 W.Face Triple 8" Boxelder.

C-5 to C-4 = 2640.00' G.L.O. 1821; 2644.67' Rowe Eng. 1995; 2644.64' Wade-Trim 1996.
C-5 to D-5 = 2645.94' G.L.O. 1821; 2646.27' Rowe Eng. 1995; 2646.12' Wade-Trim 1996.

B. Description of corner evidence found and/or method applied in restoring or reestablishing corner:

- C-5 Found 3/4" Iron Pipe in Monument Box.
WIT: S70°W 64.53' Nail/Tag#11192 N.Face 54" Cottonwood
N40°W 73.65' Nail/Tag#11192 SW Face U.Pole
N65°W 68.56' Nail/Tag#11192 S.Face Twin 14" Tree


Ratified by Peer Group in accordance with P.A. 345, 1990
Co. Rep. Carl Carlson
Date 10-30-96

The monument found was ratified by the Peer Review Committee on October 30, 1996, as the accepted corner.

C. Description of monument for corner and accessories established to perpetuate locating the position of the corner:

- C-5 Set 2" X 30" Iron Pipe with Brass Genesee County Remonumentation Cap in Monument Box at location of 3/4" Iron Pipe.

WIT: S70°W 64.53' Set 60d Nail/Genesee Co. Tag N.Face 54" Cottonwood
N40°W 73.65' Set 60d Nail/Genesee Co. Tag SW Face U.Pole
N65°W 68.56' Set 60d Nail/Genesee Co. Tag S.Face Twin 14" Tree
N25°E 66.00' Set 60d Nail/Genesee Co. Tag W.Face Triple 8" Boxelder

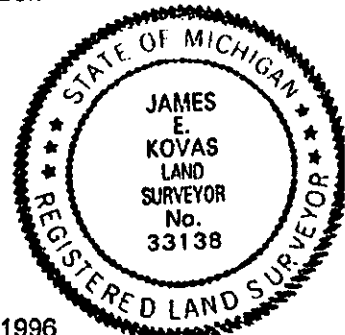

Signed by James E. Kovas Date December 20, 1996