

SURVEY & REMONUMENTATION

MASTER LIBER 4355 PAGE 116

MAR 28 2000

**1999 GENESEE COUNTY REMONUMENTATION PROGRAM
LAND CORNER RECORDATION CERTIFICATE
Filing Requirement of Act 74, Mich. P.A. 1970**

SECTION

For corners in

Genesee (County)	Located In: Richfield	Corner Code #
1. Public Land Survey	T8N R8E	C-6
	T R	
	T R	
	T R	
2. Property Controlling in Section	S T R	
	S T R	
3. Miscellaneous Property in Sec.	S T R	
	S T R	

GENESEE COUNTY REGISTER OF DEEDS

DEC 21 3 10 PM '99

M. J. ...

109084

Filed & Rec 900
Register of Deeds Stamp & File Number

4. Lot No. _____, Recorded Plat _____
5. Private Claims _____

I, Kevin B. Cleaver, in a field survey on November 30, 1999, do hereby state that under requirements of P.A. 74, Michigan P.A. of 1970, the corner points mentioned in lines 1 and 2 above were in conformance with regulations and rules therefore as required in the current manual of survey instructions of the United States Department of the Interior, Bureau of Land Management or by a decree of a Court of Law and/or that the corner points mentioned in lines 3, 4 and 5 above were in conformance with the rules of the Michigan Board of Land Surveyors or by a Decree of a Court of Law; established, re-established, monumented, recovered, found as expressed below:

	A	B	C	D	E	F	G	H	I	J	K	L	M
1													
2	6			5			4			3			1
3													
4	7			8			9			10			12
5													
6	18			17			16			15			13
7													
8	19			20			21			22			24
9													
10	30			29			28			27			25
11													
12	31			32			33			34			36
13													

NOTE: Not more than 2 corners, all in the same town and range, may be recorded on this certificate.

A. Description of original monument and accessories and/or subsequent restoration:

- 1822 General Land Office (GLO) fieldnotes: set post w/two accessories.
- Undated Genesee County Road Commission Records (GCRC): corner post w/five accessories.
- 1952 GCRC Plans: half-mile measurements to Section Corners.
- 2/22/1980 Land Corner Recordation Certificate (LCRC), Liber 2075, Page 996: 1/2" pipe in monument box w/three accessories.
- 4/25/1991 P.A. 132 Certified Survey, Liber 2428, Pages 441-443: 3/4" pipe in monument box w/four accessories and half-mile measurement.
- 9/2/1994 P.A. 132 Certified Survey, Liber 2549, Page 956: 3/4" pipe in monument box w/four accessories and half-mile measurement.
- Oct. 1995 P.A. 132 Certified Survey, Liber 2601, Pages 967-968: 3/4" pipe in monument box w/four accessories.

B. Description of corner evidence found and/or method applied in restoring or reestablishing corner:

- GLO corner and accessories not found.
- Genesee County Road Commission post and accessories not found.
- Confirmed within acceptable tolerance 1952 Genesee County Road Commission measured half-mile.
- Recovered corner and one accessory from 1980 LCRC.
- Recovered corner, four accessories, and confirmed half-mile measurement from 1991 certified survey.
- Recovered corner, four accessories, and confirmed half-mile measurement from 1994 certified survey.
- Recovered corner and four accessories from 1995 certified survey.

The monument found was ratified by the Genesee County Remonumentation Peer Review Committee on November 24, 1999.

C. Description of monument for corner and accessories established to perpetuate locating the position of the corner:


Set in concrete the standard Bernsten monument SS-A-5BR-30 with 3 1/4" brass cap stamped "Genesee County Remonumentation Corner, 1999, #29242" over 3/4" pipe in monument box.

- N 70° W 54.61' set Genesee County witness tag in south face 12" Chinese elm
- S 35° W 50.67' set Genesee County witness tag in northwest face 12" ash
- S 62° E 51.89' set Genesee County witness tag south-southwest face 14" ash
- N 70° E 49.24' set Genesee County witness tag in north-northwest face 12" elm

Ratified by Peer Group in accordance with P.A. 345, 1990

Co. Rep. Carl Carlsen
Date 11-24-99

Signed by Kevin B. Cleaver
Surveyor's Michigan License No. 29242

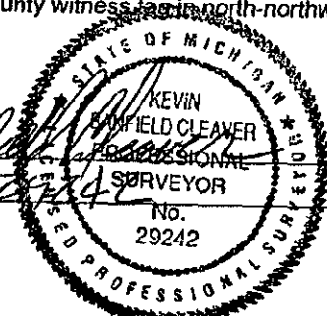

Date 12/20/99