

**SURVEY & REMONUMENTATION**


MAY 31 2000

**SECTION**

**1996 Remonumentation Program  
LAND CORNER RECORDATION CERTIFICATE  
Filing Requirement of Act 74, Mich. P.A. 1970**

For corners in

_____ Genesee _____	Located In:	Corner Code #
(county)		
1. Public Land Survey	T 8N R 8E	E-4
	T _____ R _____	_____
	T _____ R _____	_____
	T _____ R _____	_____
2. Property Controlling in Section	S _____ T _____ R _____	_____
	S _____ T _____ R _____	_____
3. Miscellaneous Property in Sec.	S _____ T _____ R _____	_____
	S _____ T _____ R _____	_____

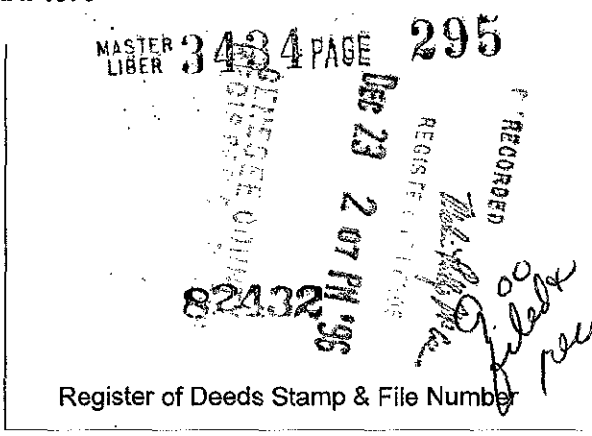

4. Lot No. \_\_\_\_\_, Recorded Plat \_\_\_\_\_

5. Private Claims \_\_\_\_\_

I, James E. Kovas, in a field survey on September 25, 1996, do hereby certify that under requirements of P.A. 74, Michigan P.A. of 1970, the corner points mentioned in lines 1 and 2 above were in conformance with regulations and rules therefore as required in the current manual of survey instructions of the United States Department of the Interior, Bureau of Land Management or by a decree of a Court of Law and/or that the corner points mentioned in lines 3, 4 and 5 above were in conformance with the rules of the Michigan Board of Land Surveyors or by a Decree of a Court of Law; established, re-established, monumented, re-monumented, recovered, found as expressed below:

	A	B	C	D	E	F	G	H	I	J	K	L	M
2	6		5		4		3		2		1		
3													
4	7		8		9		10		11		12		
5													
6	13		17		16		15		14		13		
7													
8	19		20		21		22		23		24		
9													
10	30		29		28		27		26		25		
11													
12	31		32		33		34		35		36		
13													

**NOTE: Not more than 4 corners, all in the same town and range, may be recorded on this certificate.**

**A. Description of original monument and accessories and/or subsequent restoration:**

- E-4 1821 - G.L.O. Set 1/4 Post WIT: West 6 Lks. W.Oak; N57°E 10 Lks. Sugar
- 1965 - Genesee Co. Section Notes, Found Wood Stake/ Reset with 3/4" Iron Rod WIT: SW 81.3' Nail 18" Elm; NE 50.7' Road Sign; ENE 73.9' Nail 20" Twin Maple; SE 48.0' Nail P.Pole.
- 1980 - C.H.M.P., Survey (L.2078, P.59), no monument description, no accessories
- 1987 - Rowe Eng., Survey, 3/4" Iron Rod WIT: N70°E 73.85' Nail/Tag#11192 S.Face Twin 14" Maple; S45°E 47.90' P.K. Nail/Tag#11192 NW Face U.Pole; N10°W 109.03' P.K.Nail/Tag#11192 E.Face 20" Hickory.

Distances: E-4 to E-5 = 2640.00' G.L.O. 1821; 2660.98' Wade-Trim 1996.

**B. Description of corner evidence found and/or method applied in restoring or reestablishing corner:**


- E-4 Found 3/4" Iron Rod
- WIT: N70°E 73.89' Fnd Nail/Tag#11192 S.Face Twin 14" Maple  
S45°E 47.98' Fnd P.K.Nail/Tag#11192 NW Face P.Pole  
N10°W 109.00' Fnd P.K.Nail/Tag#11192 E.Face 20" Hickory

Ratified by Peer Group in accordance with P.A. 345, 1990  
Co. Rep. Carl Carter  
Date 10-30-96

The monument found was ratified by the Peer Review Committee on October 30, 1996, as the accepted corner.

**C. Description of monument for corner and accessories established to perpetuate locating the position of the corner:**

- E-4 Set 2" X 30" Iron Pipe with Brass Genesee County Remonumentation Cap at location of Fnd 3/4" Iron Rod
- WIT: N70°E 74.64' Set 60d Nail/Genesee Co. Tag S.Face 36" Maple  
N38°E 64.68' Set 60d Nail/Genesee Co. Tag NW Face U.Pole  
N10°W 109.36' Set 60d Nail/Genesee Co. Tag E.Face 30" Maple  
S85°W 33.02' Fnd 1/2" Iron Rod (Prop. Cor.)  
S33°E 47.86' Fnd Nail SW Face U.Pole

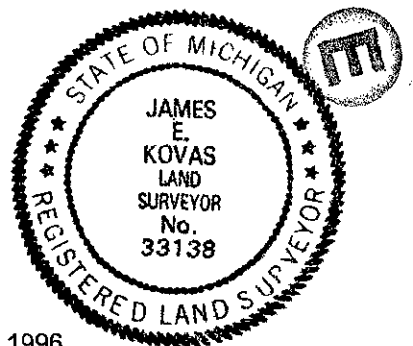

Signed by James E. Kovas

Date December 20, 1996

Surveyor's Michigan License No. 33138